



TOTAL SF AVAILABLE -1,536 RSF (16%)

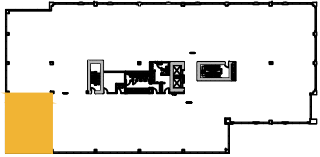

Key Plan

[Click to access 3D model](#)

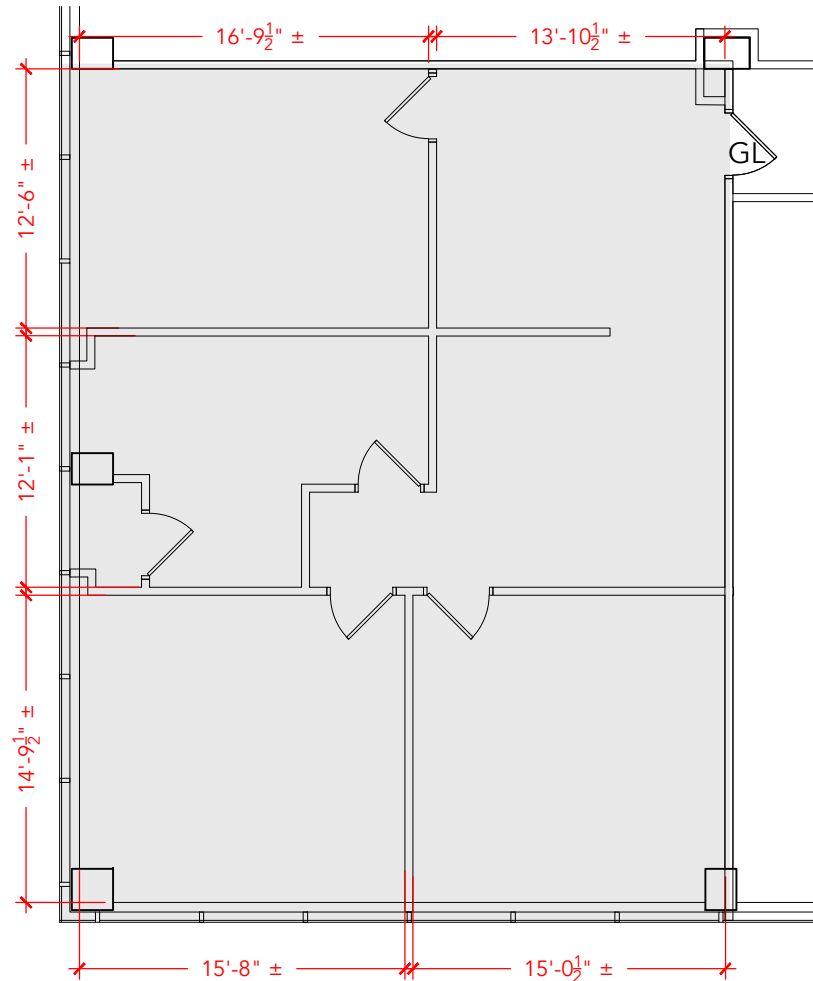

Floor Plan