



TOTAL SF AVAILABLE - 2,326 RSF(12%)

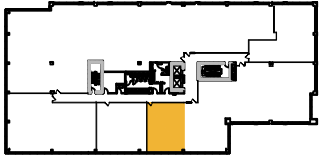

Key Plan

[Click to access 3D model](#)

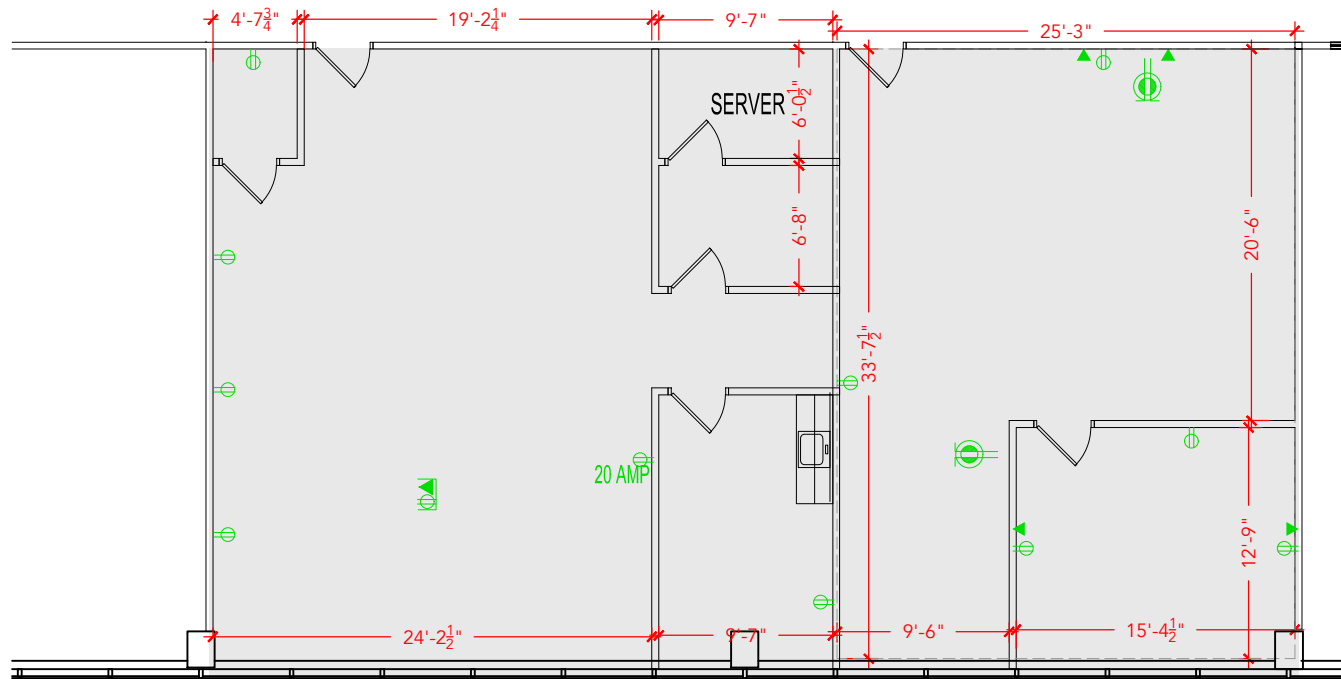

SUITE 250
06.18.19(TD)
1,340 RSF(12%)

SUITE 260-262
06.18.19(TD)
986 RSF(12%)

Floor Plan