
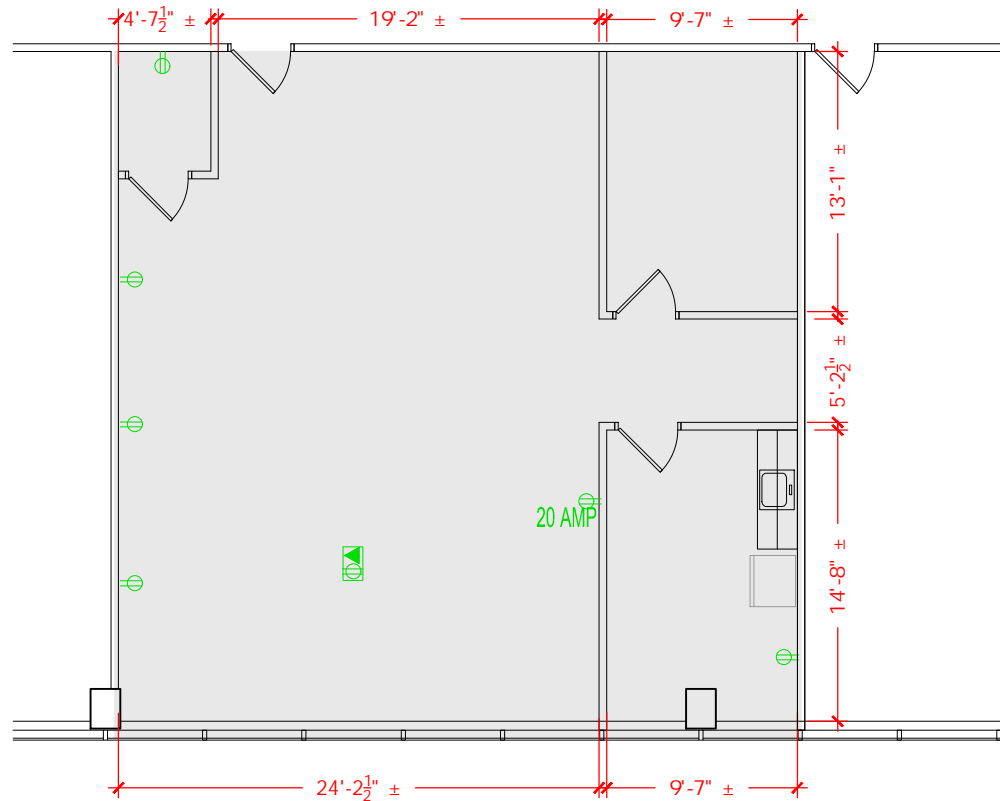
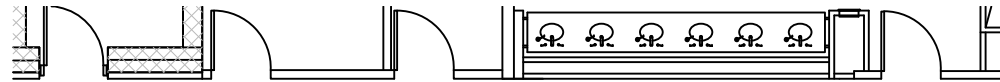


TOTAL SF AVAILABLE - 1,387 RSF (16%)

[Click to access 3D model](#)

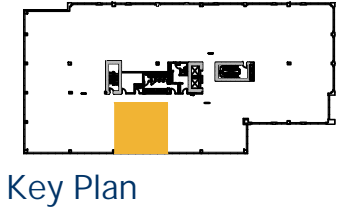

Floor Plan