

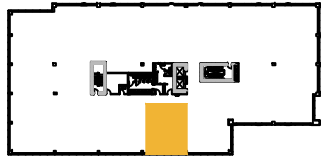


TOTAL SF AVAILABLE - 986 RSF (12%)

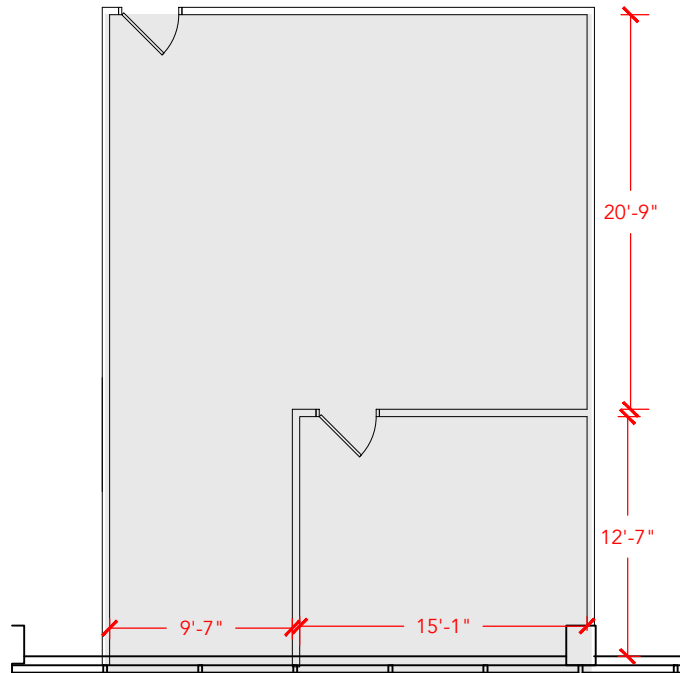

Key Plan

[Click to access 3D model](#)

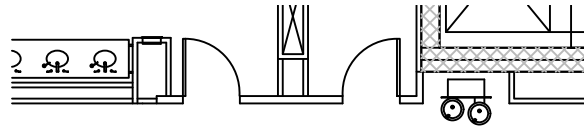

Floor Plan