



OWINGS MILLS CORPORATE CAMPUS

10045 RED RUN BLVD OWINGS MILLS, MD 21117 SUITE 100-110

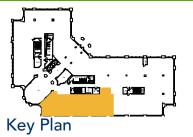

TOTAL SF AVAILABLE - 3,300 RSF(12%)

Click to access3D model

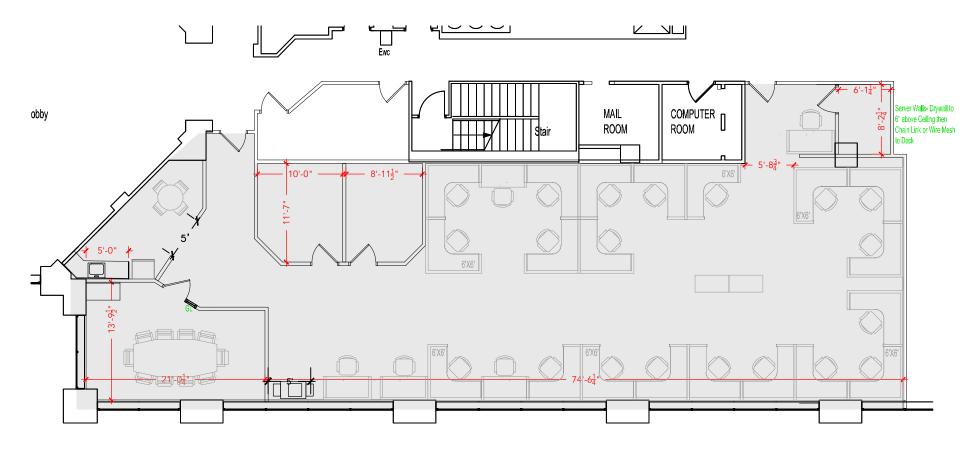

Floor Plan