


Key Plan

TOTAL SF AVAILABLE - 1,182 RSF (12%)

[Click to access 3D model](#)

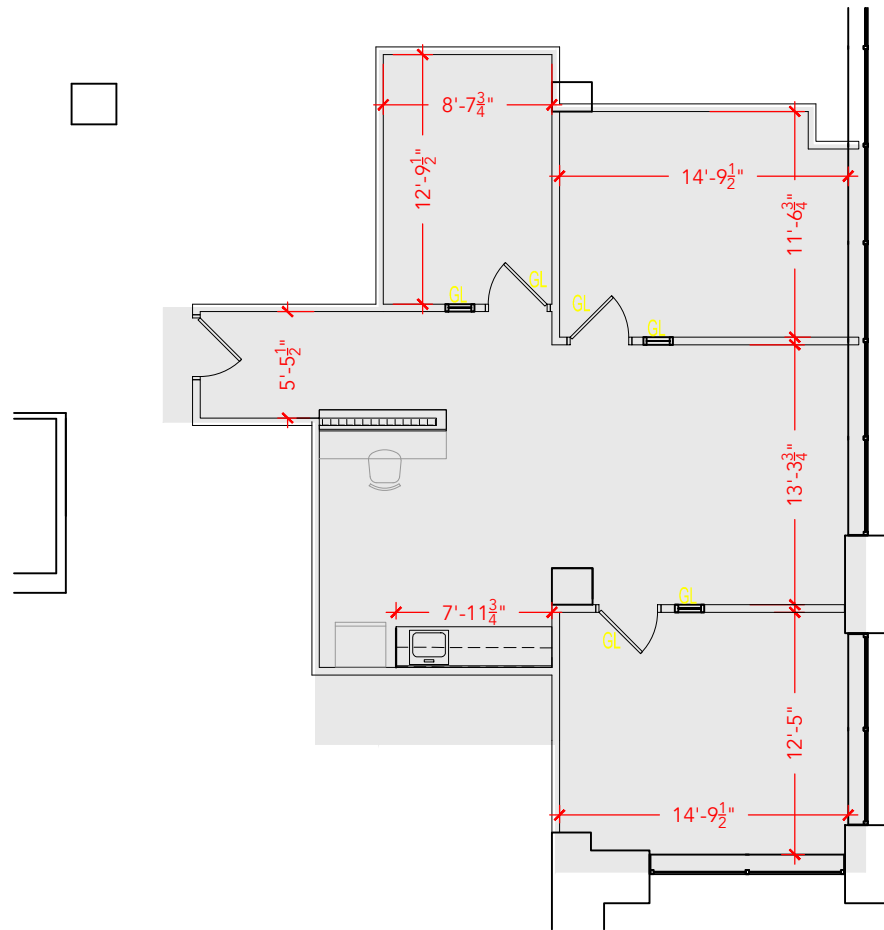

## Floor Plan