


TOTAL SF AVAILABLE -1,953 RSF (12%)

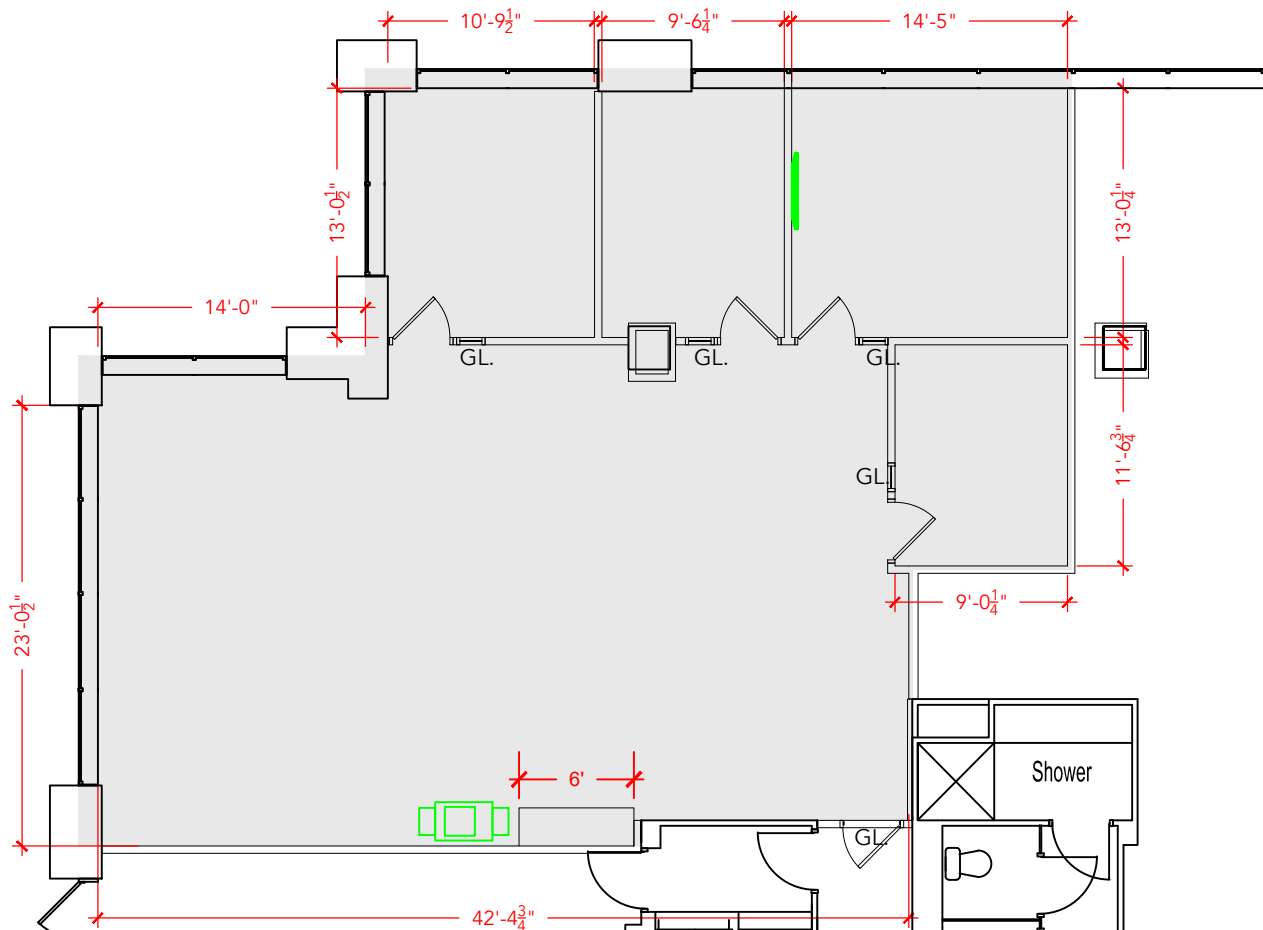

Key Plan

[Click to access 3D model](#)

Floor Plan