


TOTAL SF AVAILABLE -1,532 RSF(12%)



Key Plan

[Click to access CADD file](#)

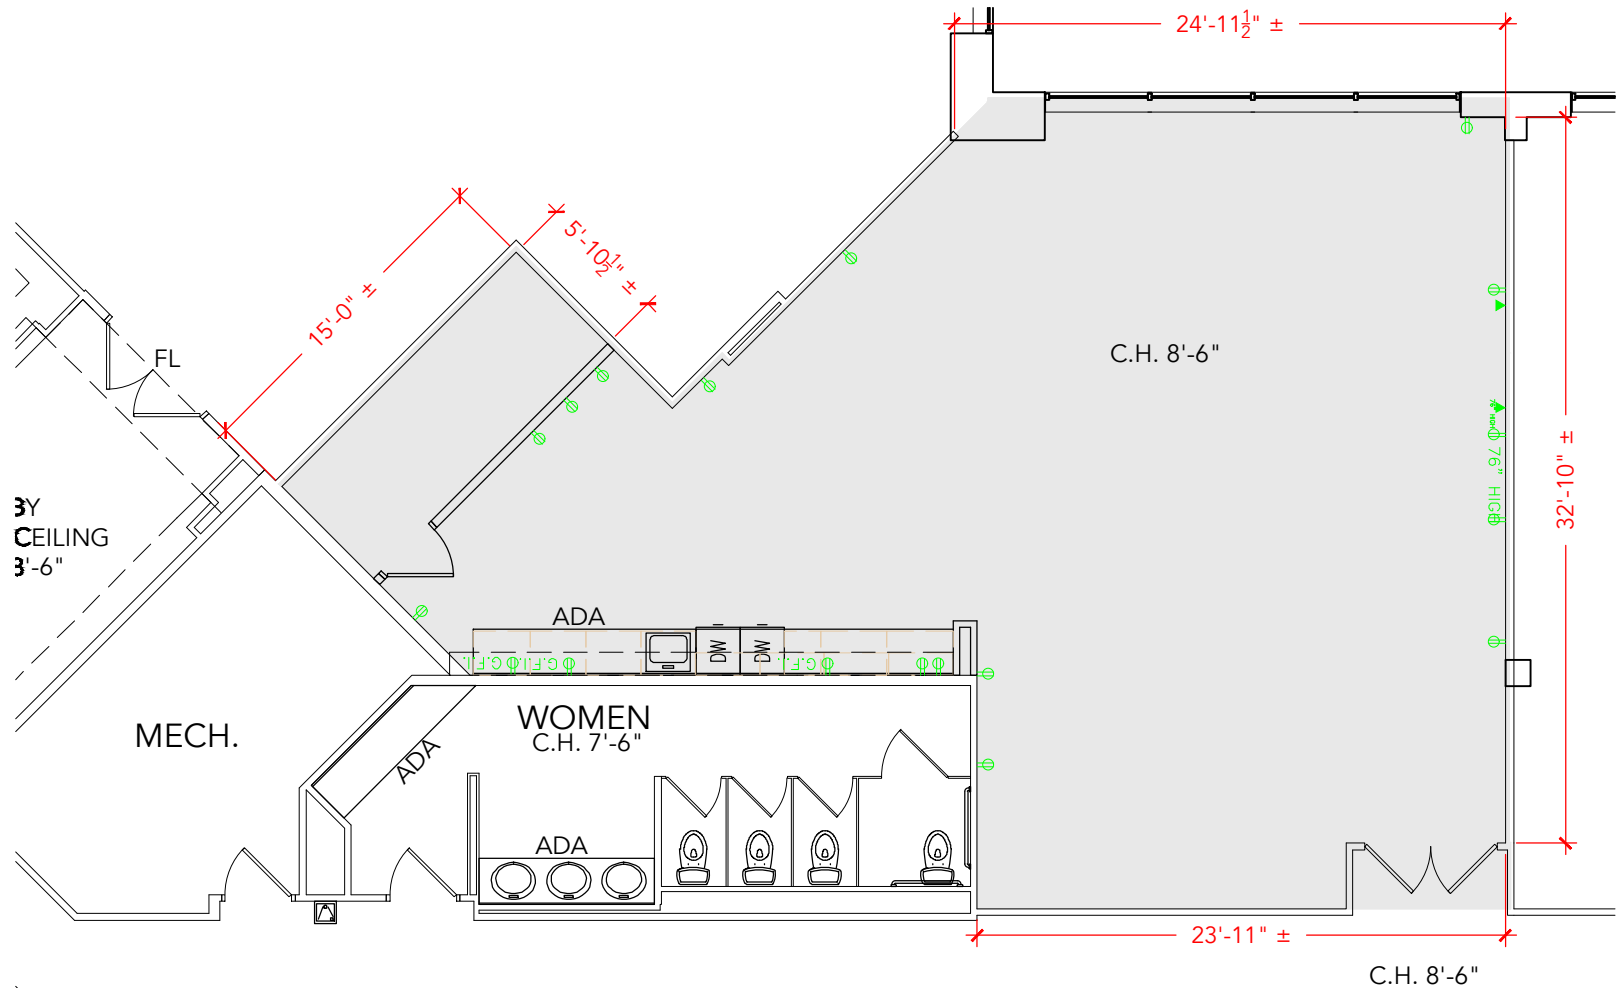

Floor Plan