


Key Plan

TOTAL SF AVAILABLE -3,765 RSF(12%)

[Click to access CADD file](#)

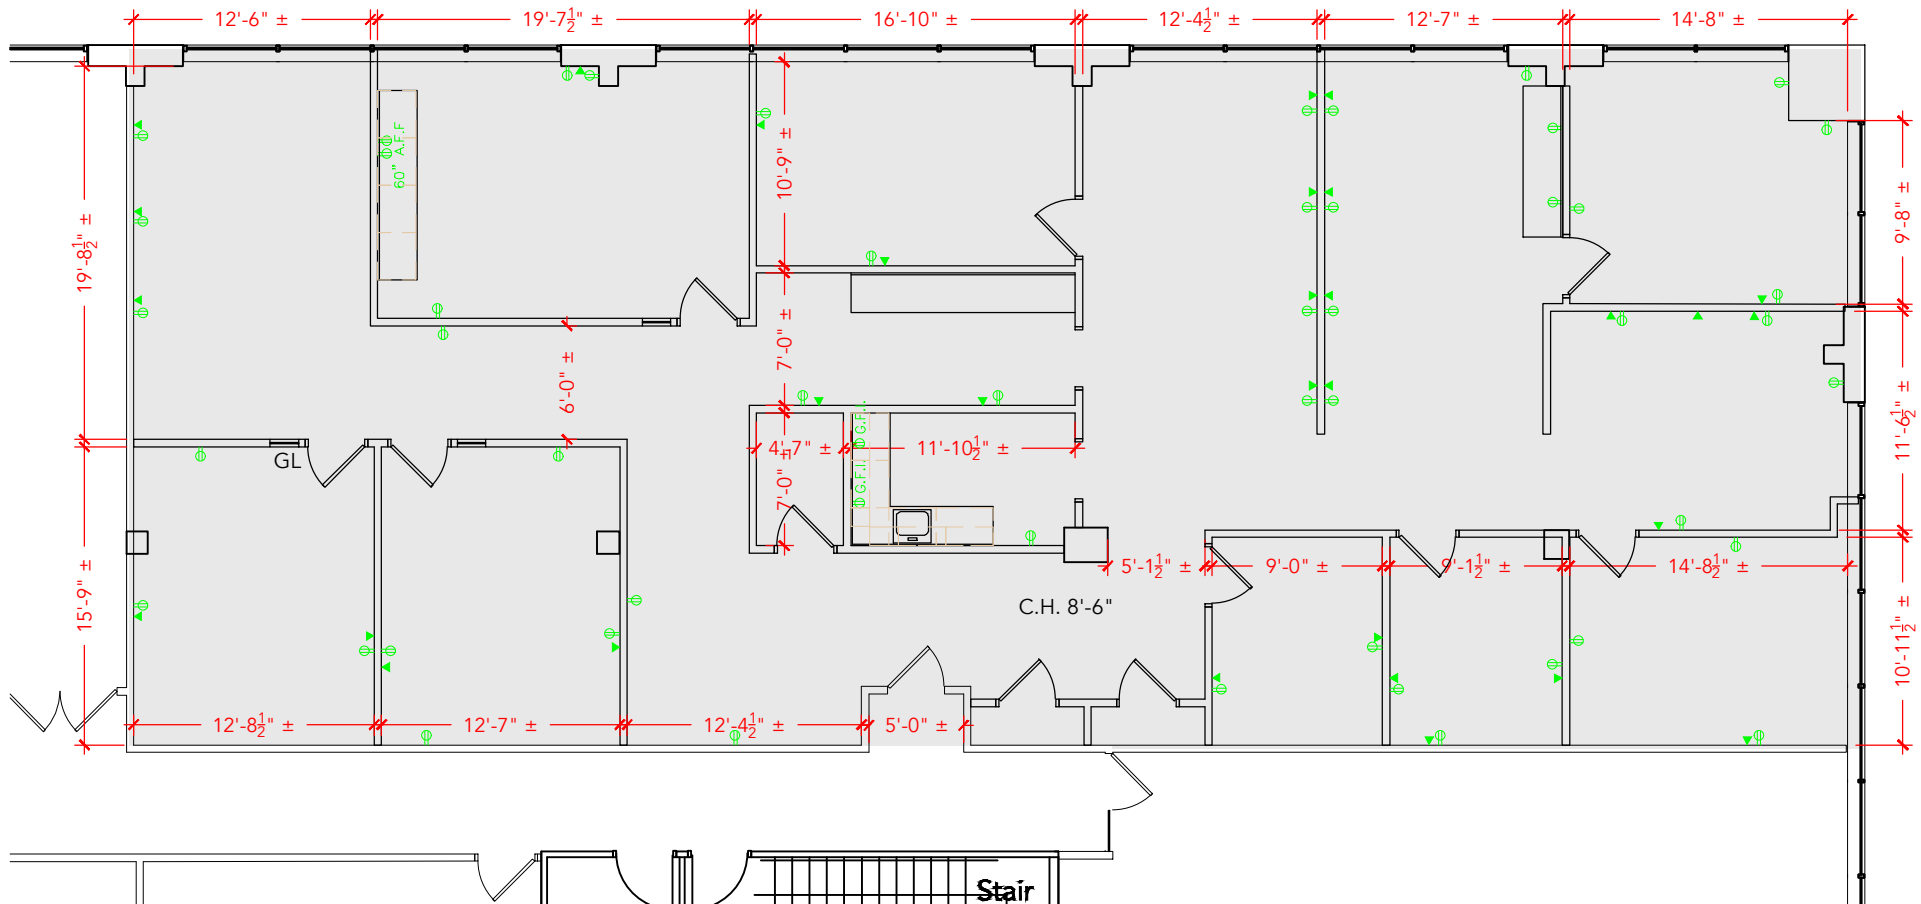

Floor Plan