



TOTAL SF AVAILABLE -2,771 RSF(12%)

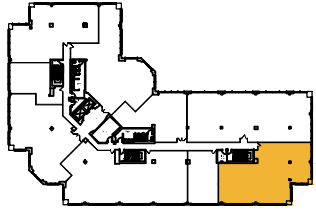

Key Plan

[Click to access CADD file](#)

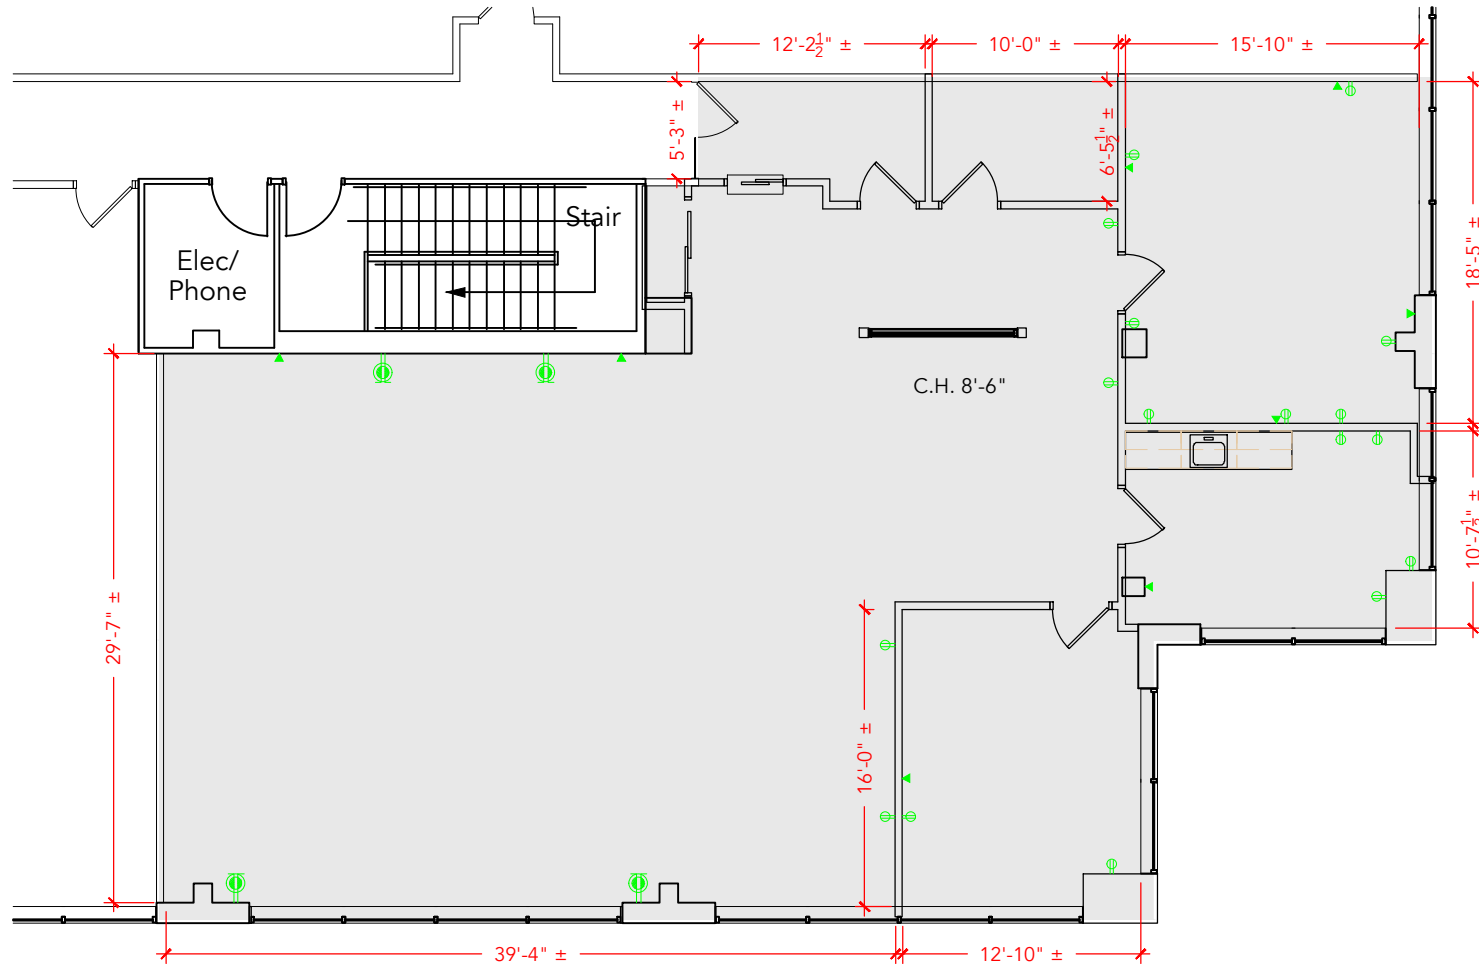

Floor Plan