


Key Plan

TOTAL SF AVAILABLE - 971 RSF(12%)

[Click to access 3D model](#)

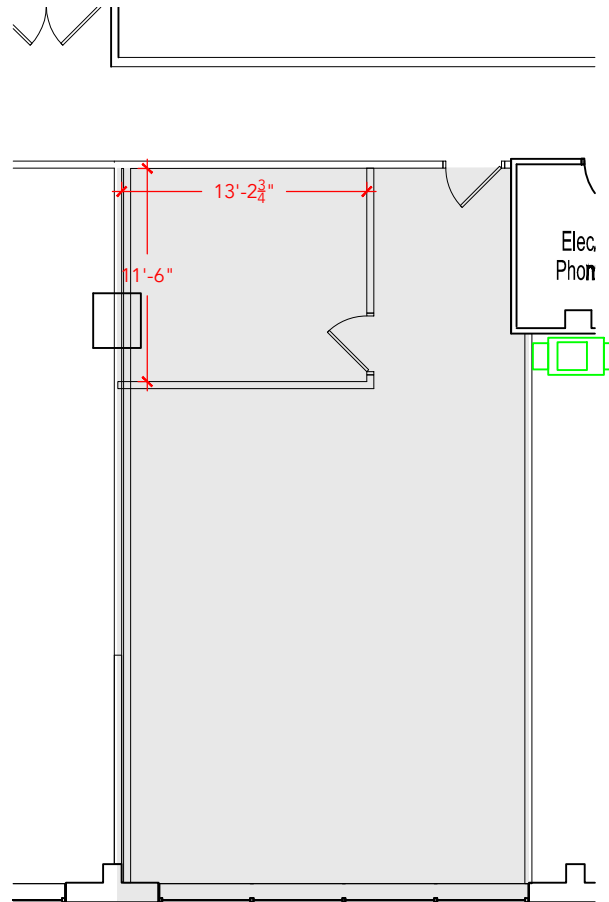

Floor Plan