




Key Plan

TOTAL SF AVAILABLE - 1,005 RSF(12%)

[Click to access 3D model](#)

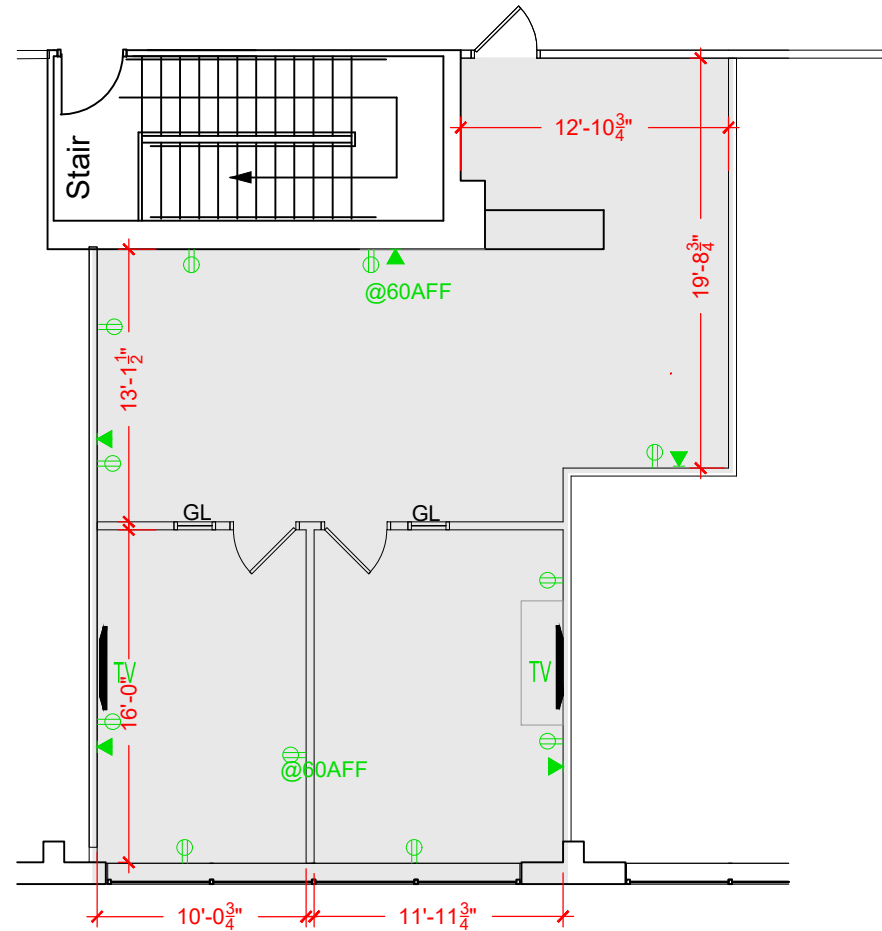

Floor Plan