
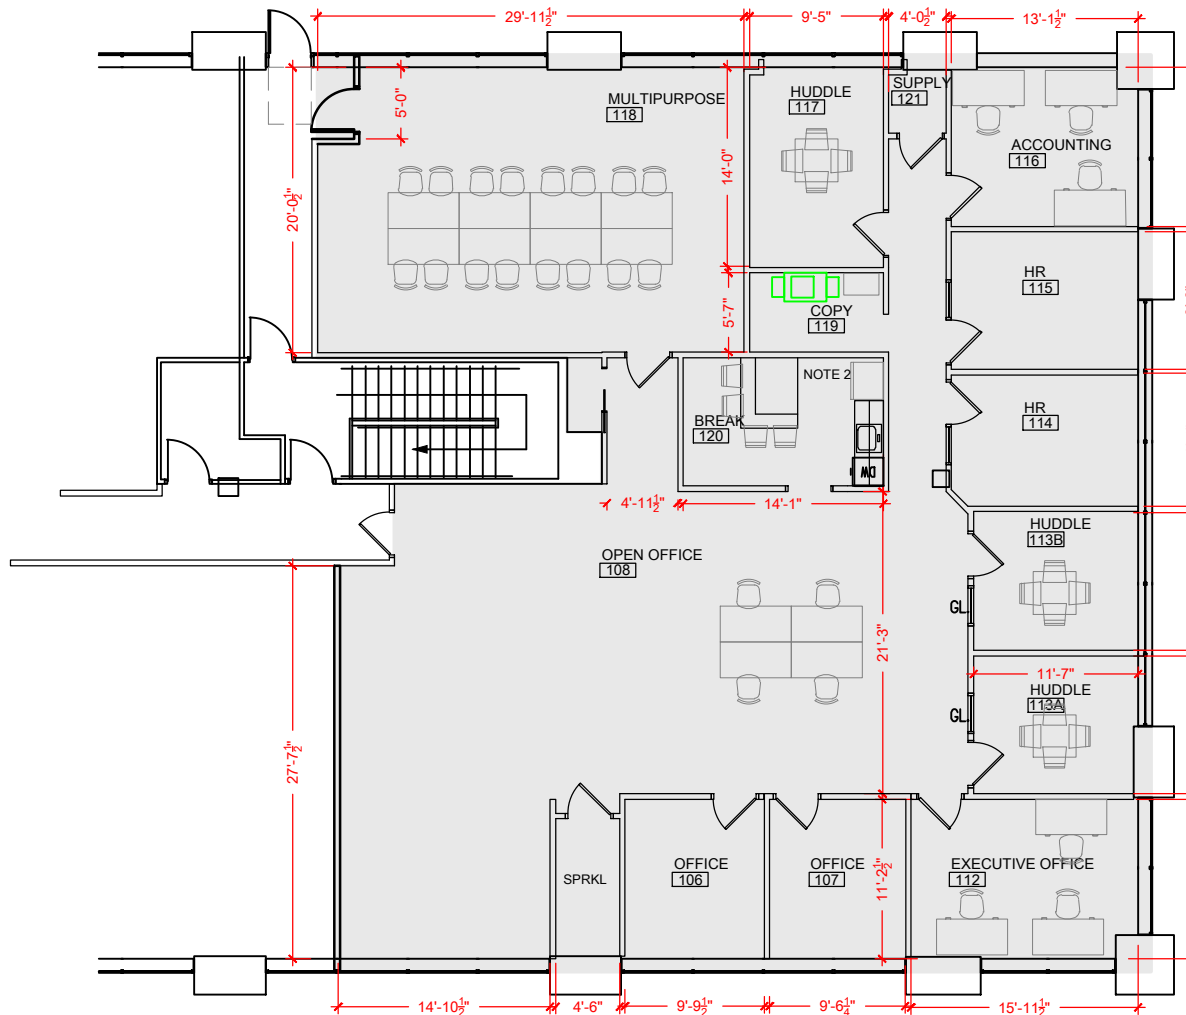


TOTAL SF AVAILABLE - 3,967 RSF (12%)

[Click to access CADD file](#)

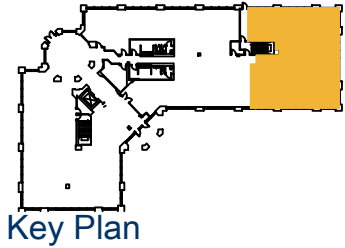

Floor Plan