



TOTAL SF AVAILABLE - 2,240 RSF (12%)

[Click to access CADD file](#)

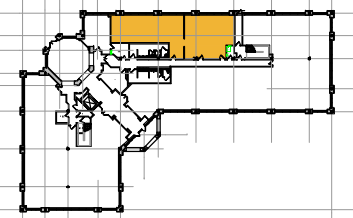

Key Plan

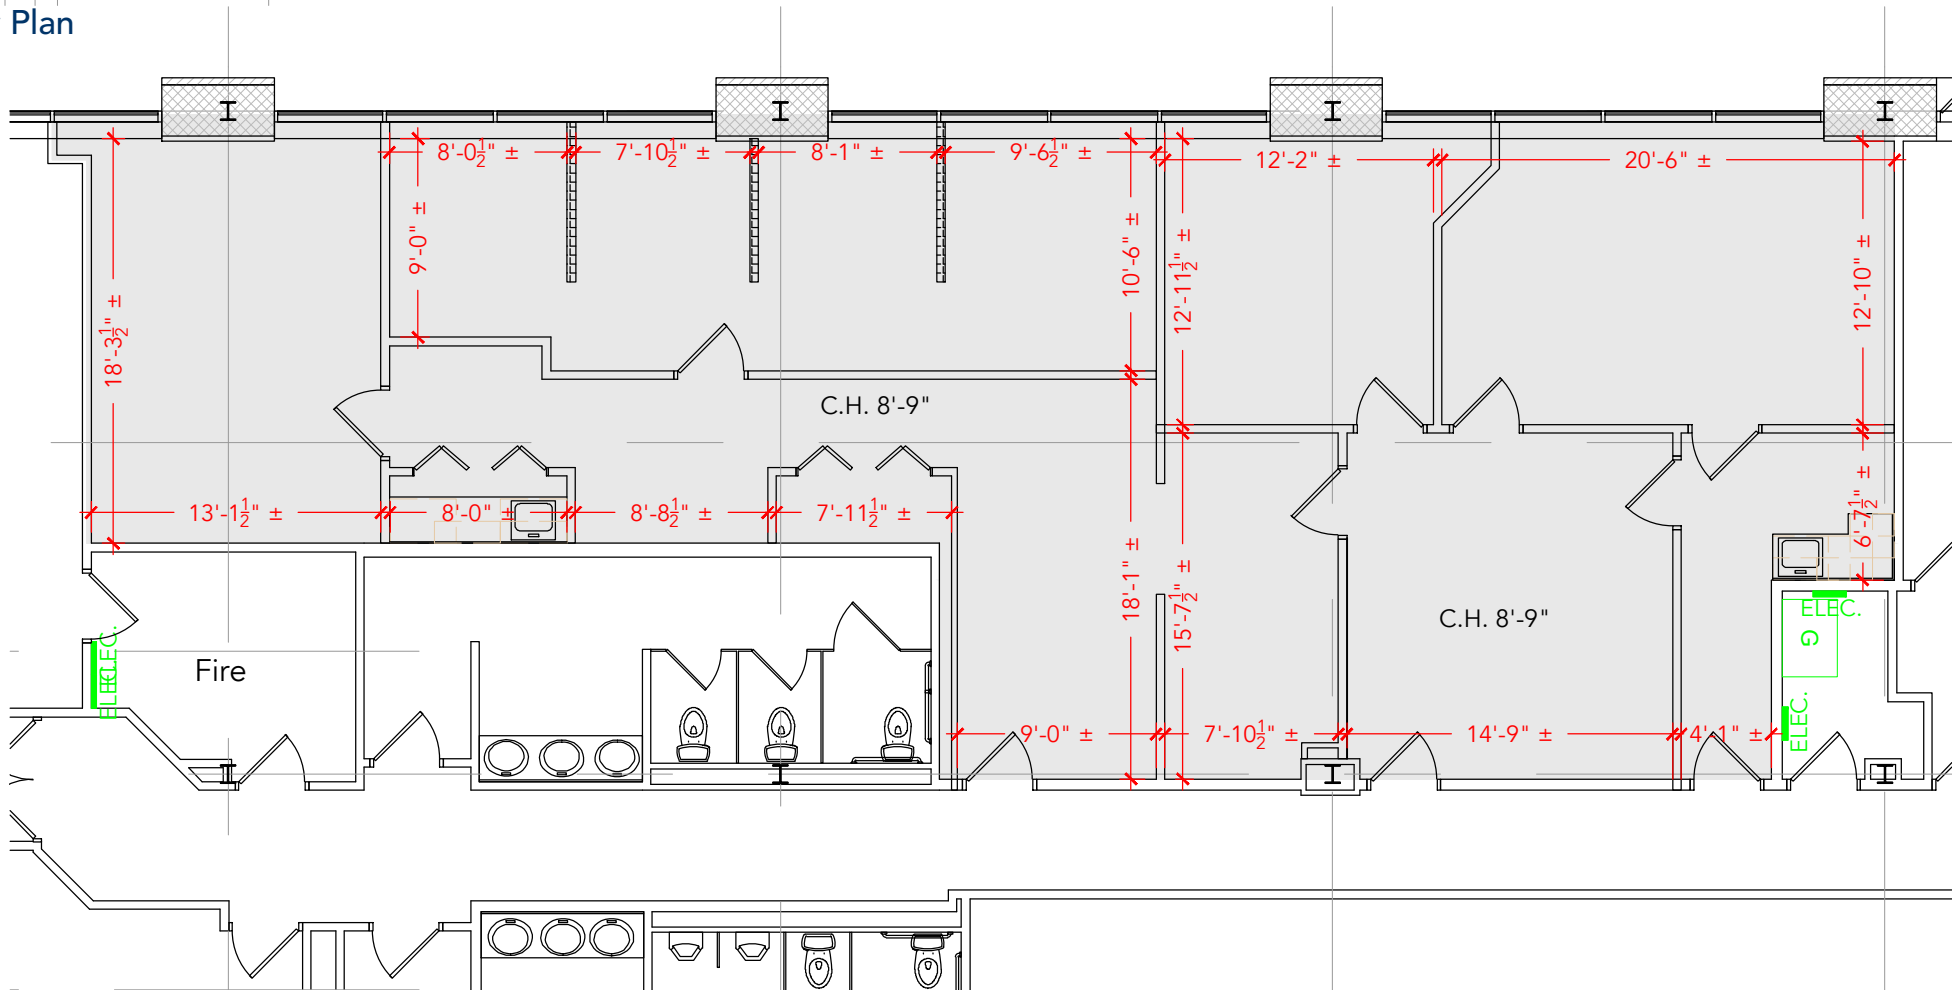

Floor Plan