



TOTAL SF AVAILABLE -5,011 RSF (12%)

[Click to access 3D model](#)

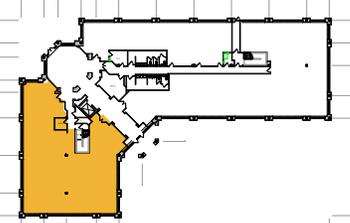

Key Plan

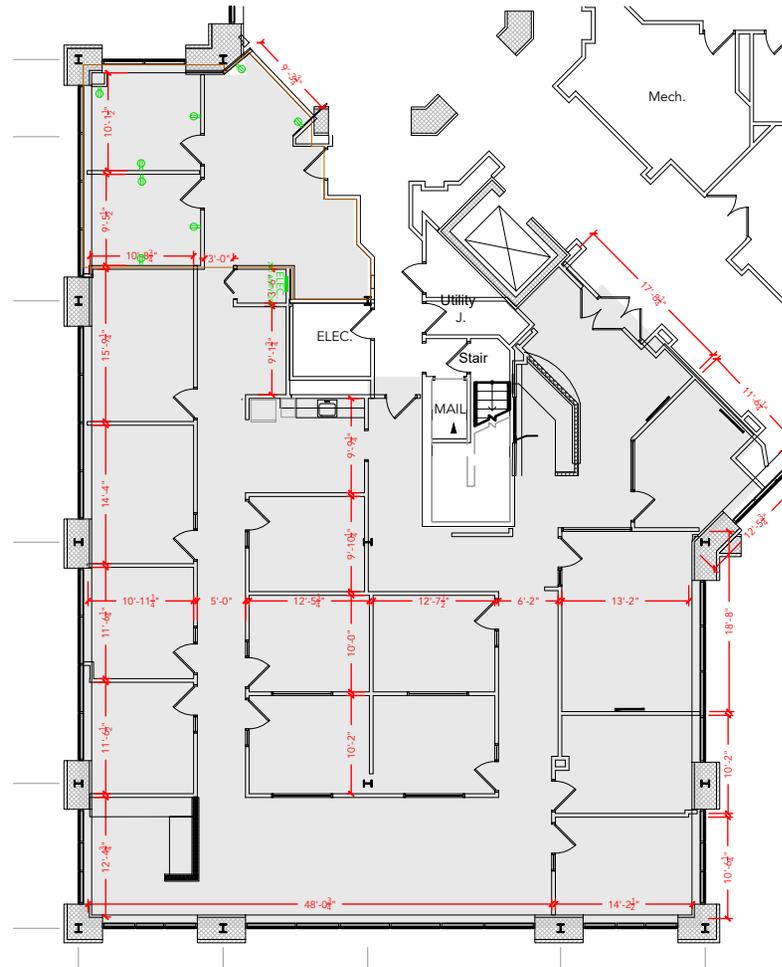

Floor Plan