




Key Plan

TOTAL SF AVAILABLE -1,089 RSF (12%)

[Click to access CADD file](#)

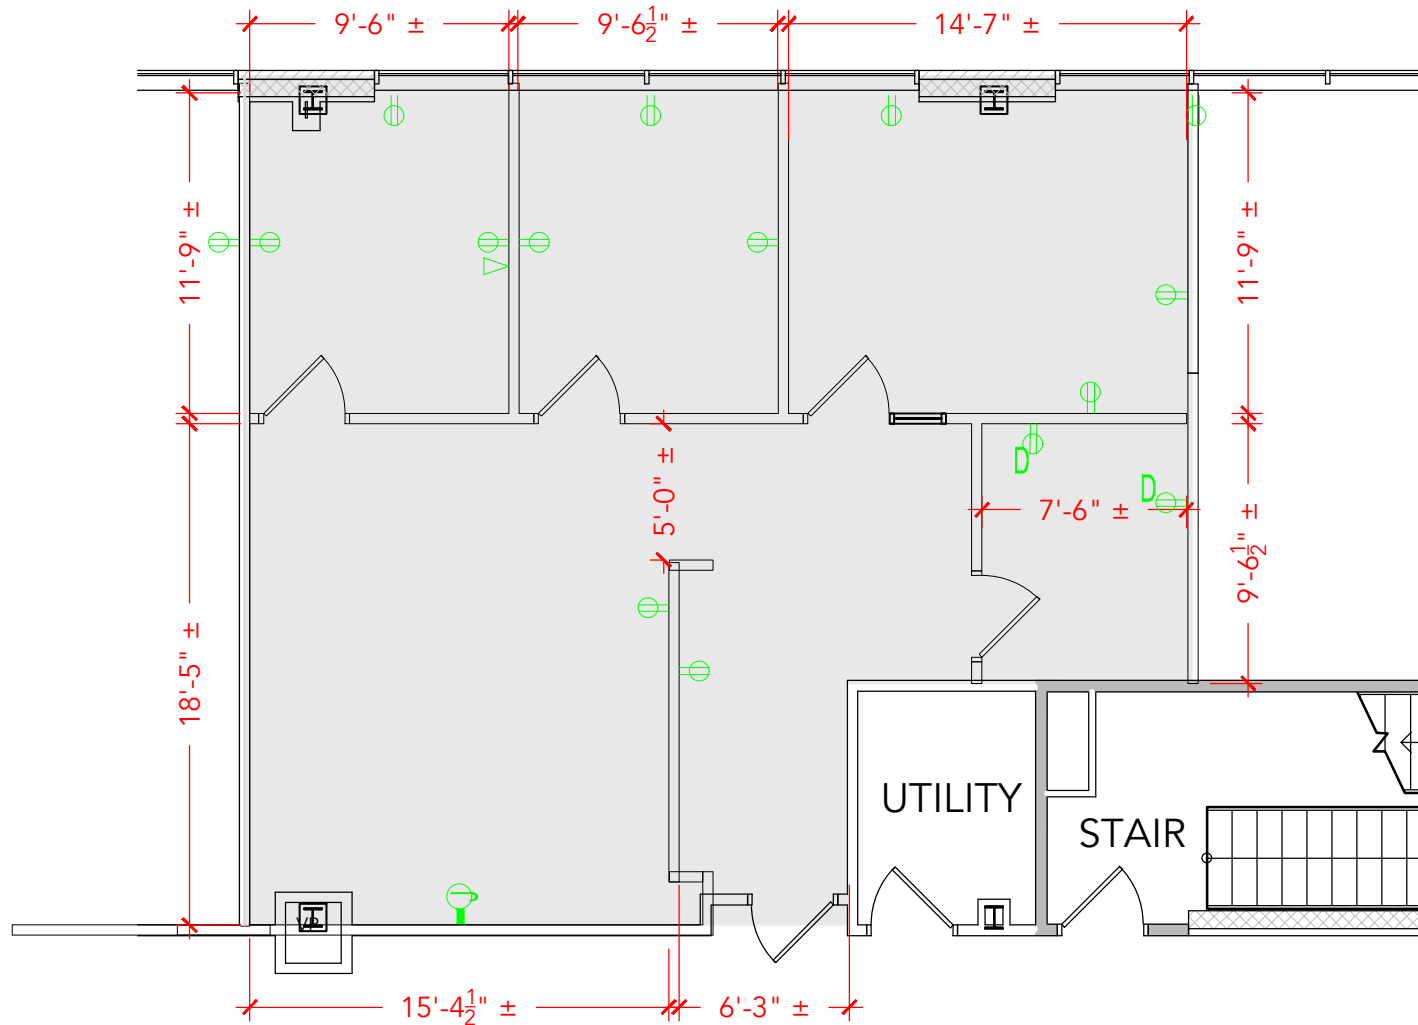

Floor Plan