
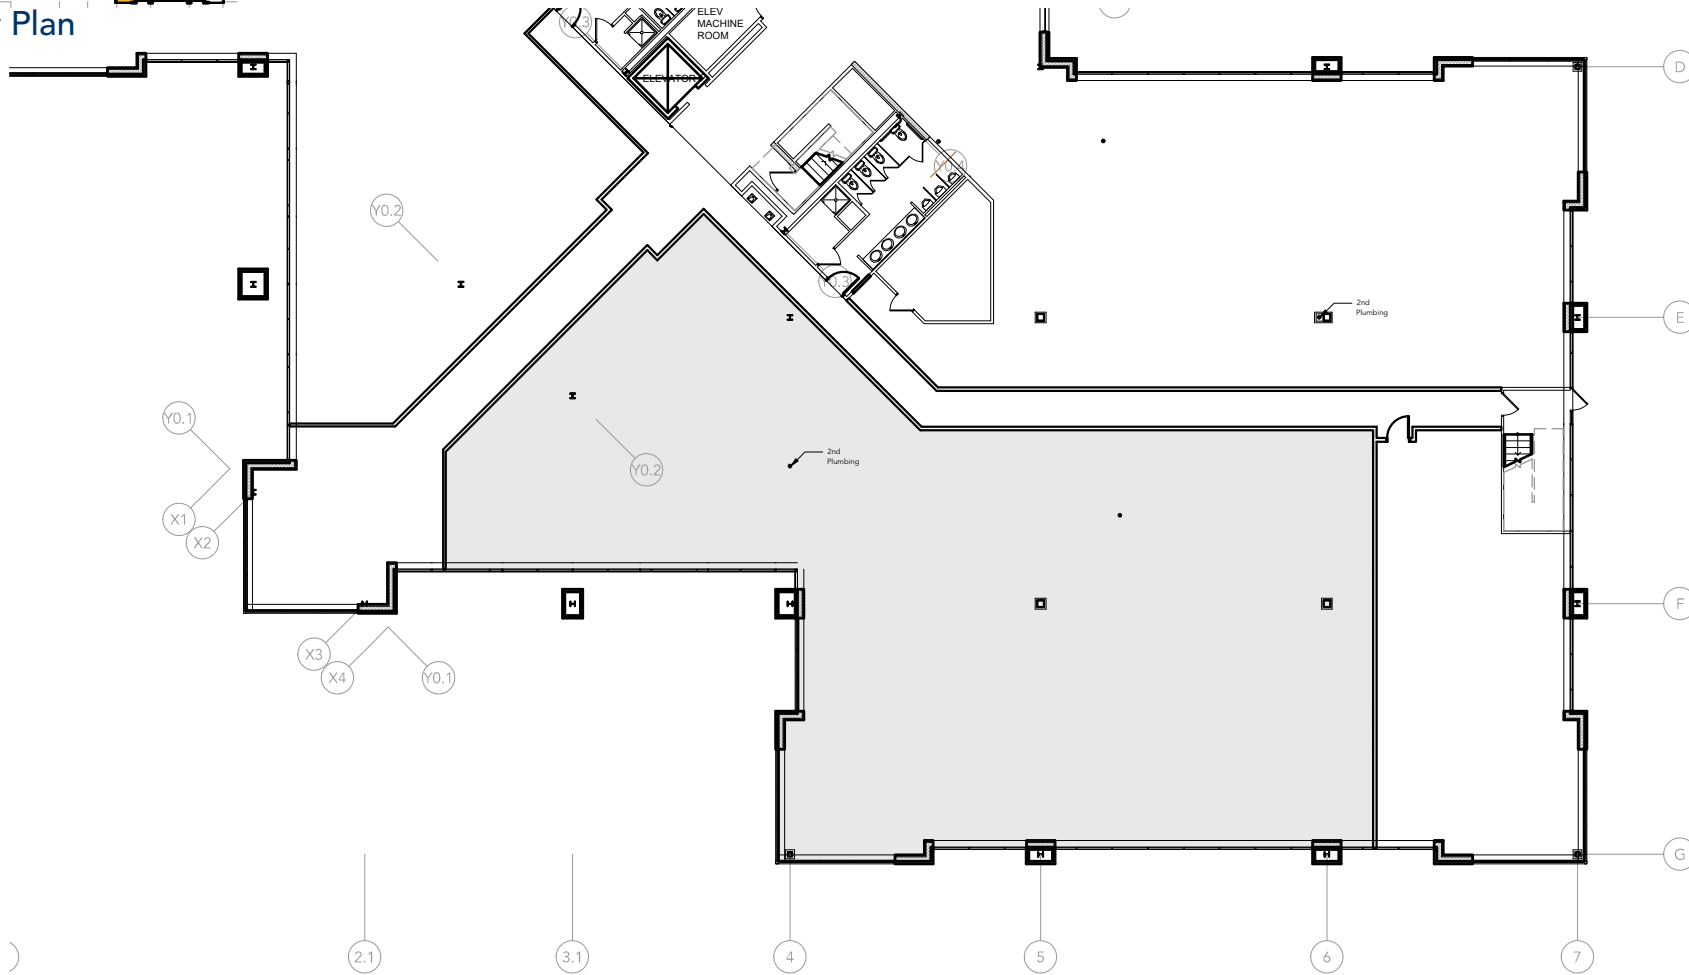


TOTAL SF AVAILABLE - 7,543 RSF(12%)

[Click to access 3D model](#)

Key Plan

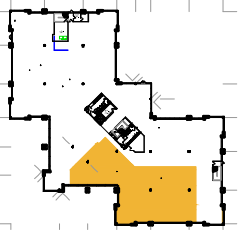

Floor Plan