


TOTAL SF AVAILABLE -31,939 RSF (12%)



Key Plan

[Click to access 3D model](#)

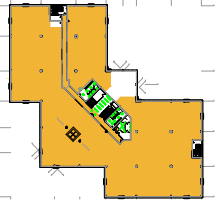

Floor Plan