


TOTAL SF AVAILABLE - 9,600 SF

OFFICE - 3,234 SF


WAREHOUSE SF - 6,366 SF

* 3,065 MEZZ NOT INCLUDED IN TOTAL SQFT

[Click to access 3D model](#)

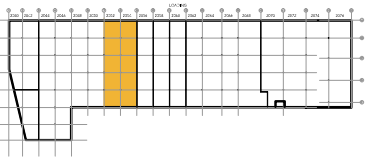

Key Plan

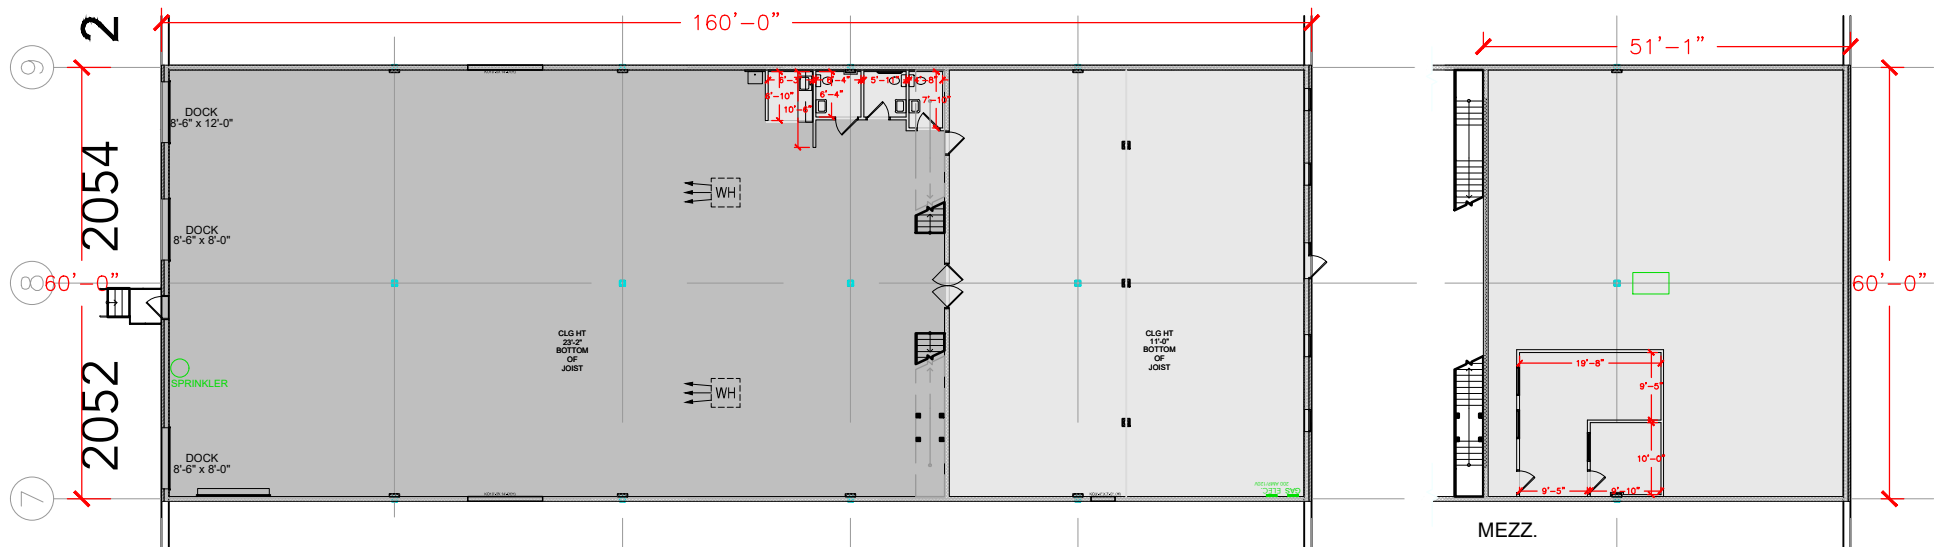

Floor Plan