


TOTAL SF AVAILABLE - 19,408 SF


OFFICE - 1,308 SF

WAREHOUSE - 18,100 SF

[Click to access 3D model](#)

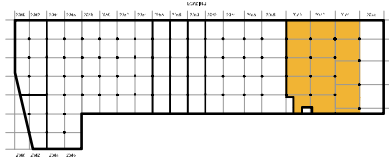

Key Plan

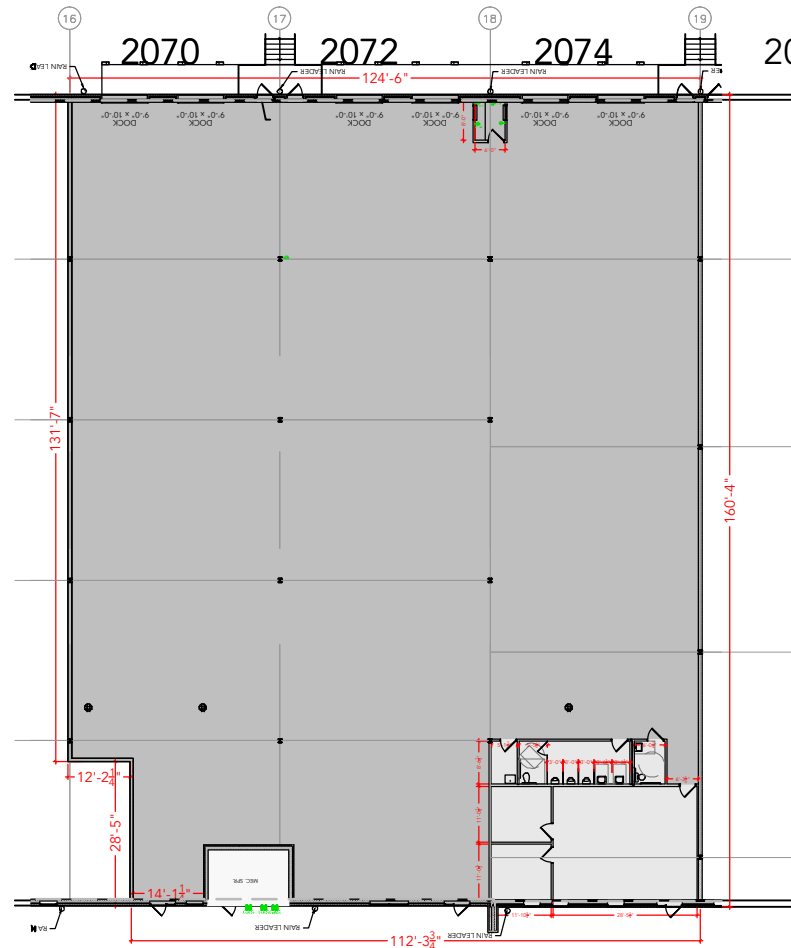

Floor Plan