


TOTAL SF AVAILABLE - 27,300 SF


OFFICE - 1,811 SF

WAREHOUSE SF - 25,489 SF

[Click to access 3D model](#)

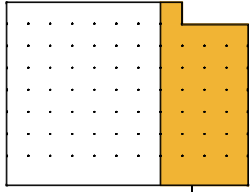

Key Plan

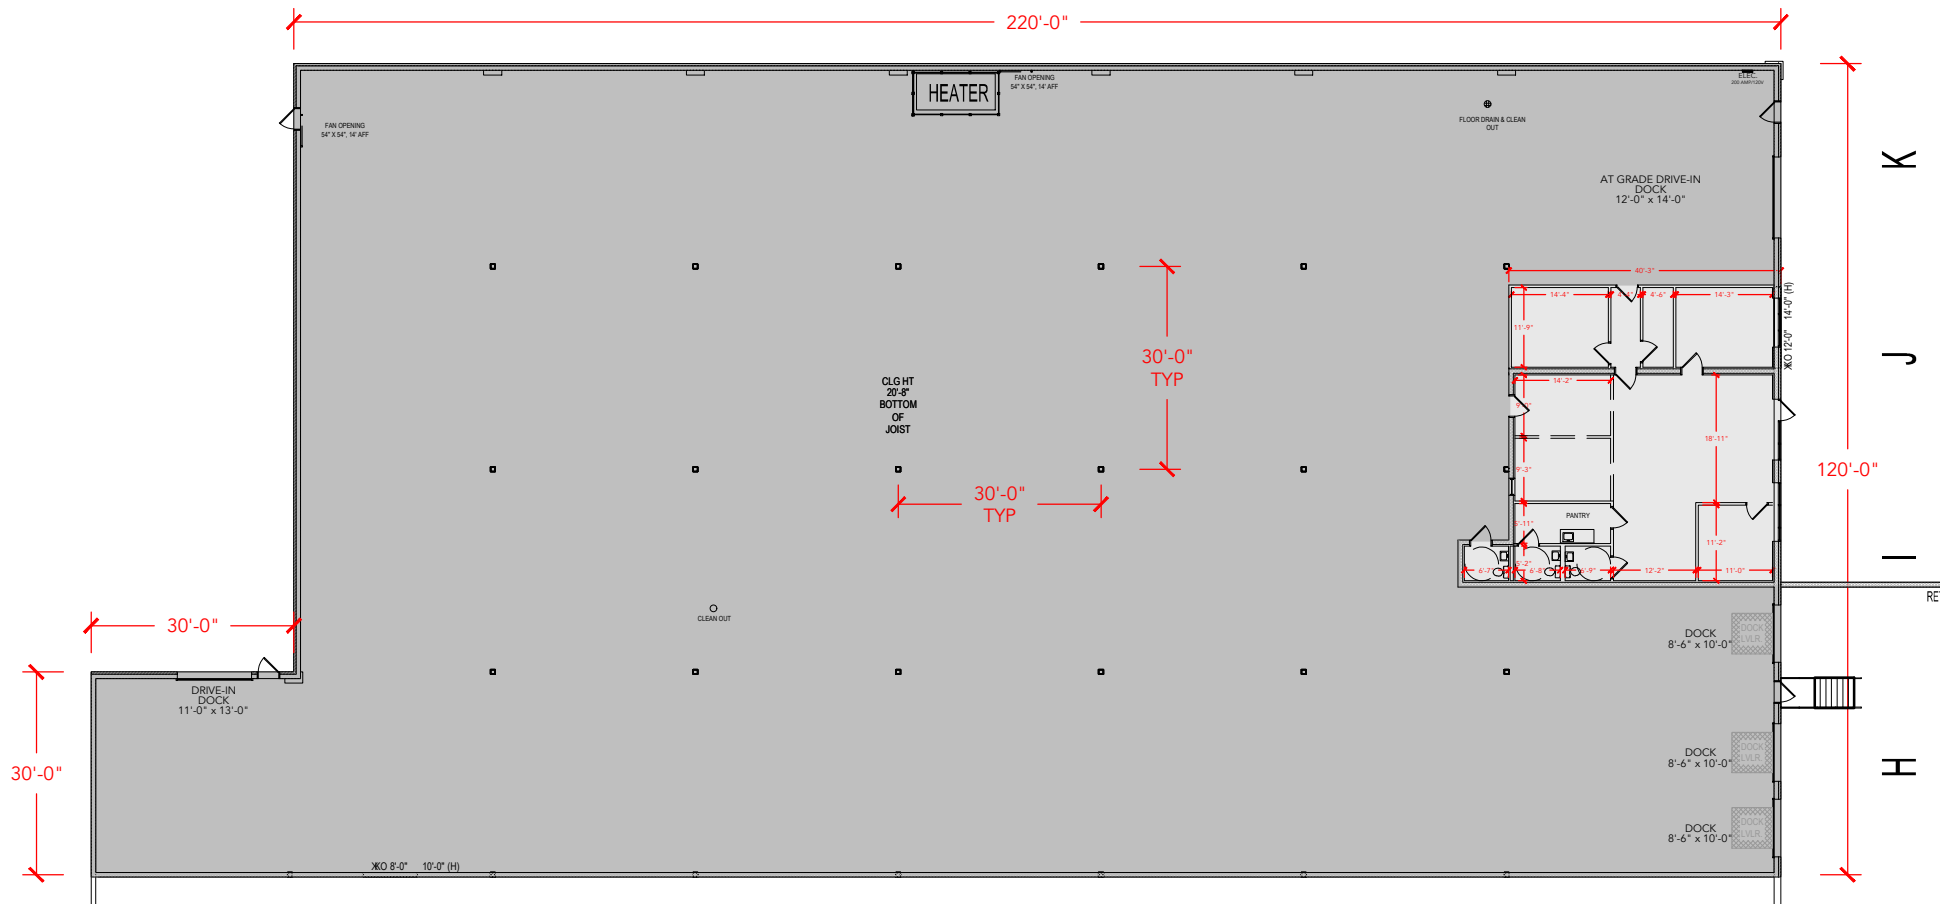

Floor Plan