



TOTAL SF AVAILABLE - 1,105 RSF (12%)

[Click to access 3D model](#)

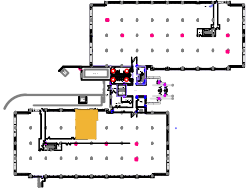

Key Plan

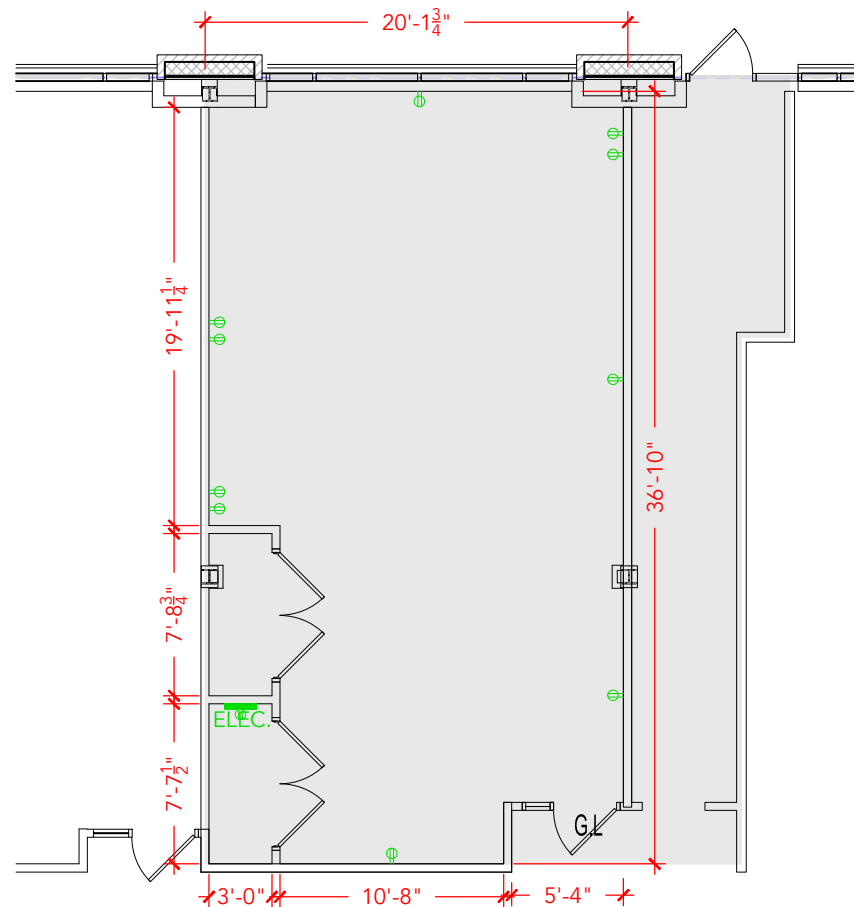

## Floor Plan