



TOTAL SF AVAILABLE -1,654 RSF (12%)

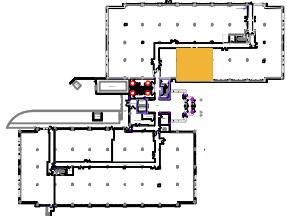

Key Plan

[Click to access CADD file](#)

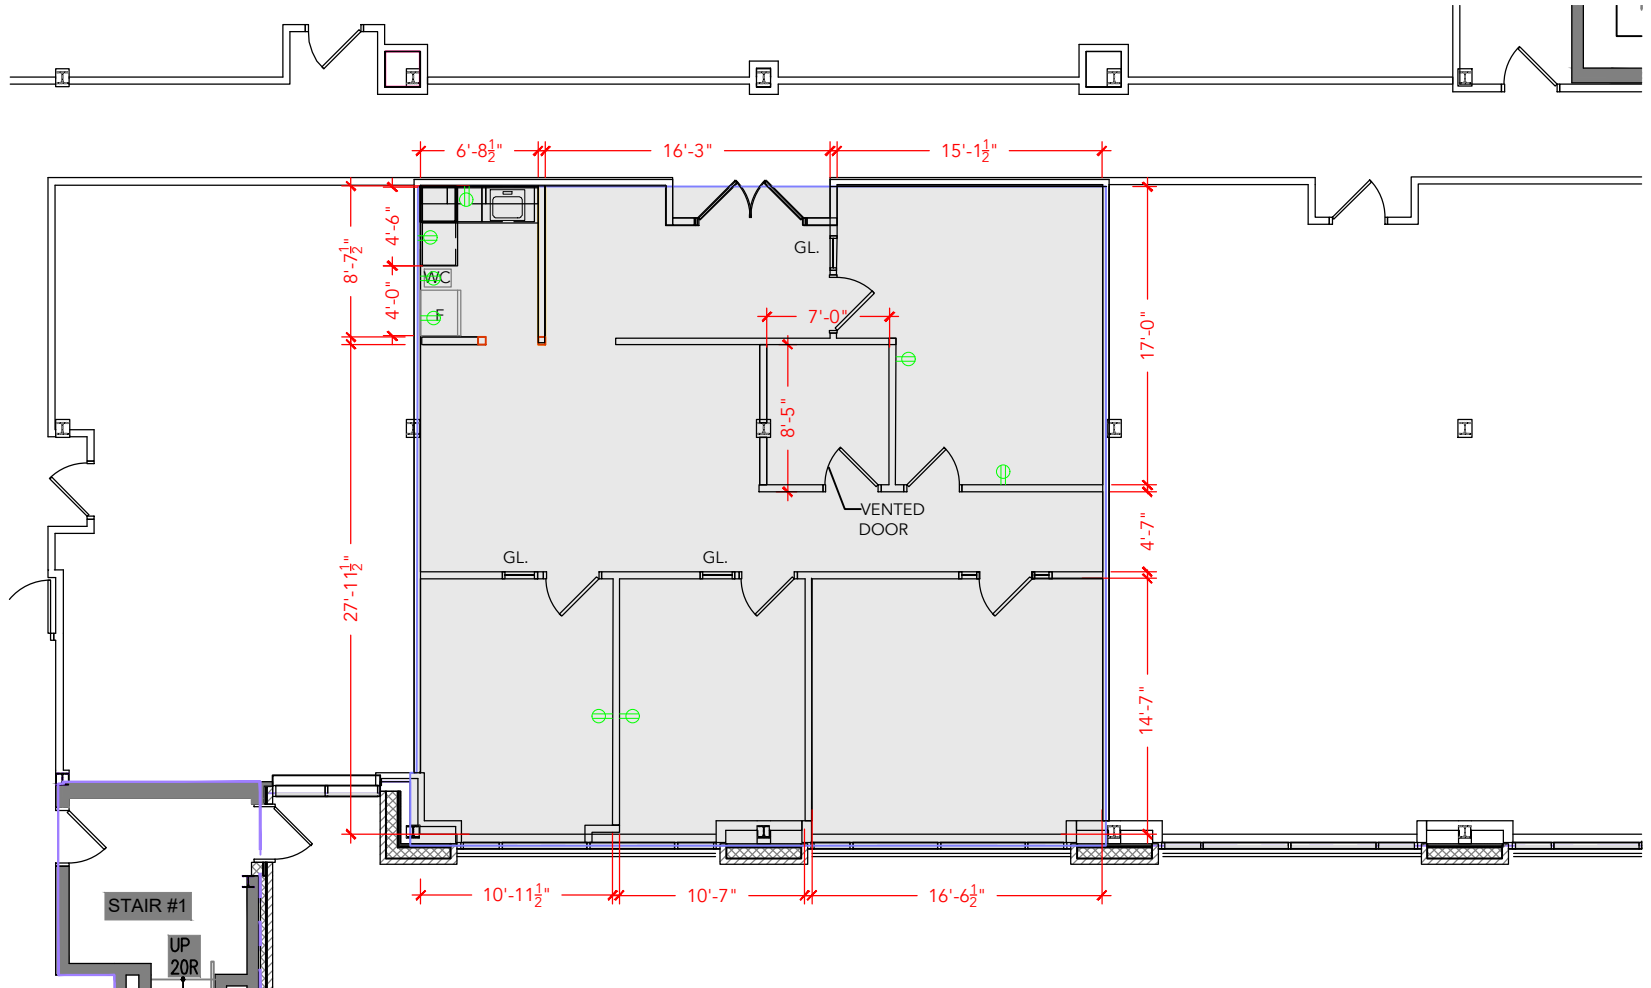

Floor Plan