


TOTAL SF AVAILABLE -6,540 RSF(12%)

[Click to access CADD file](#)

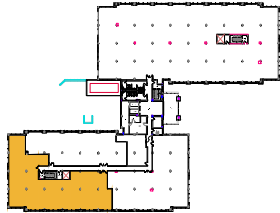

Key Plan


Q
S

T

U

V

W

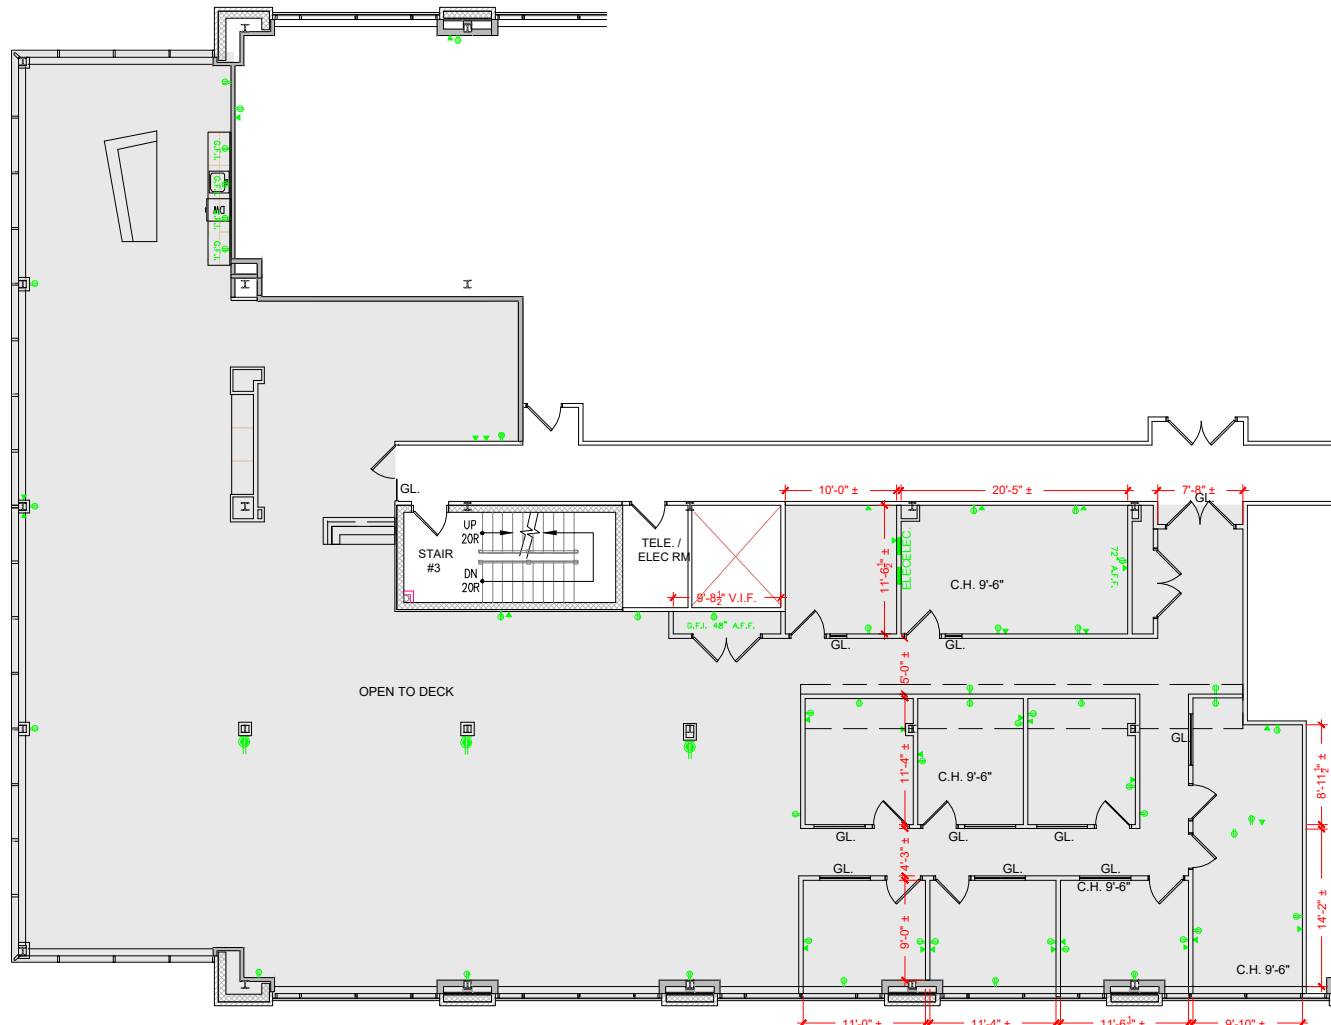

Floor Plan