



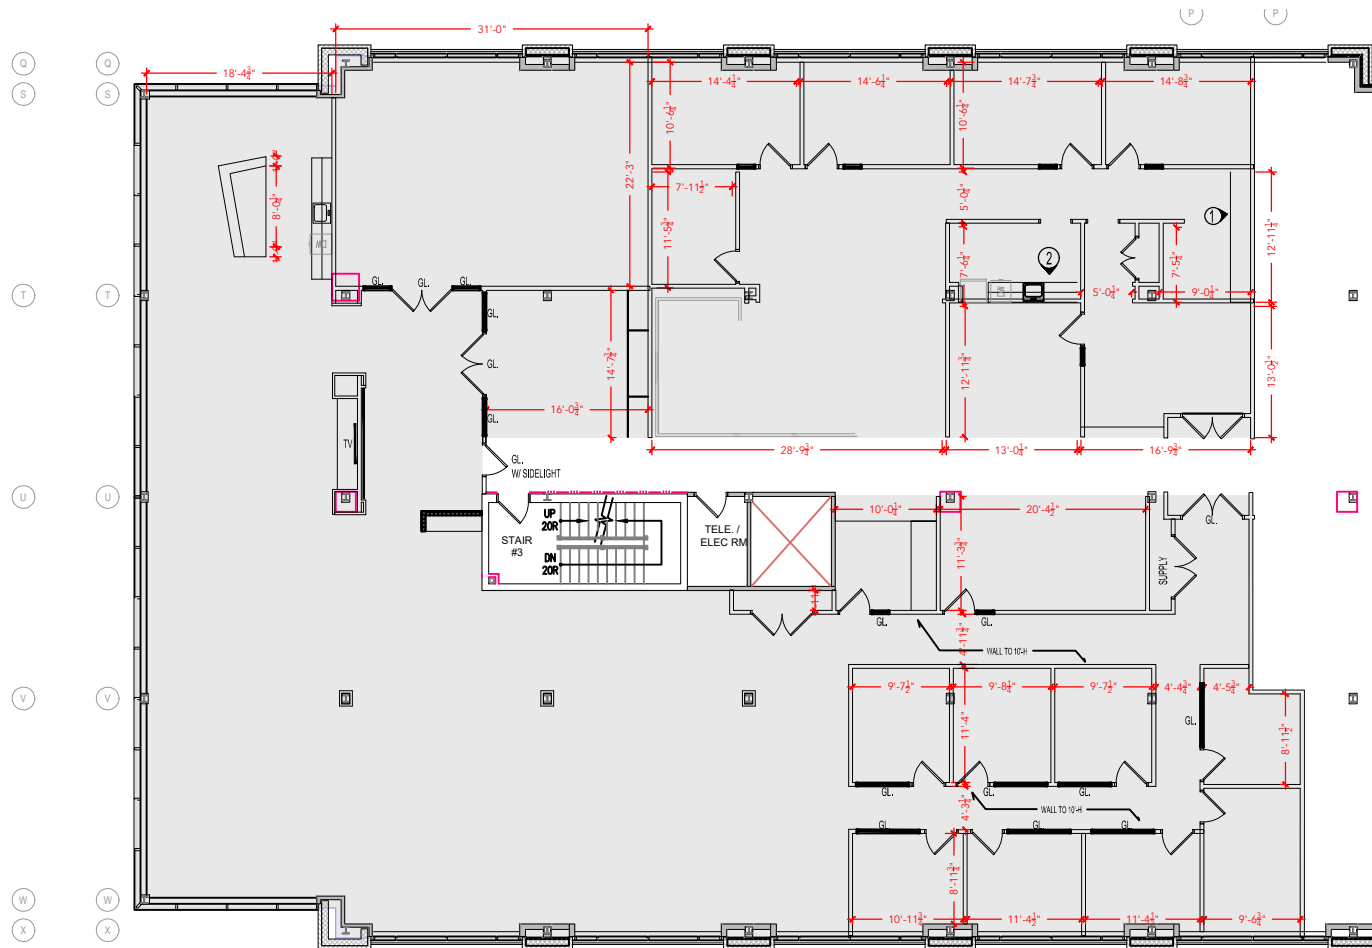

[Click to access 3D model](#)

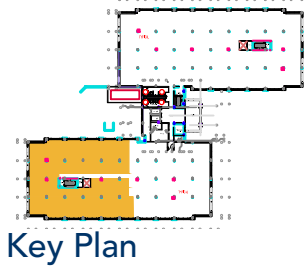

Floor Plan

PLAN NOT TO SCALE - THIS IS NOT A CONSTRUCTION DOCUMENT

DRAWING #: SC10-212-234 ASBUILT DATE: NEEDS TO BE