



TOTAL SF AVAILABLE - 977 RSF(12%)

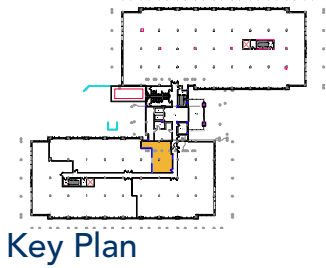

[Click to access 3D model](#)

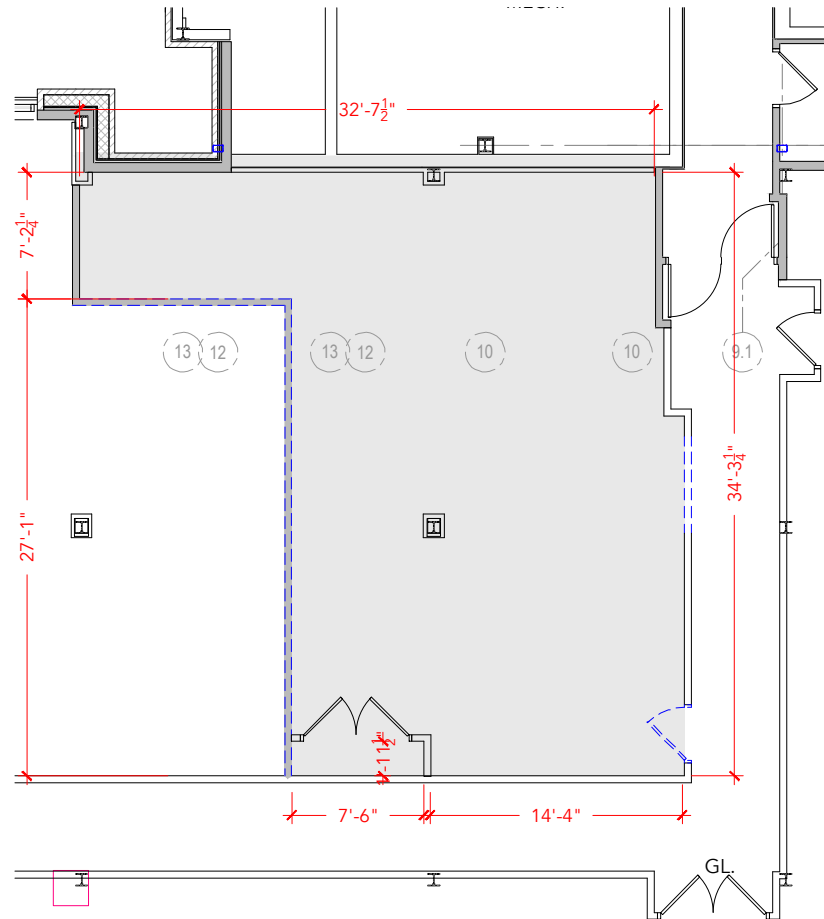

## Floor Plan