
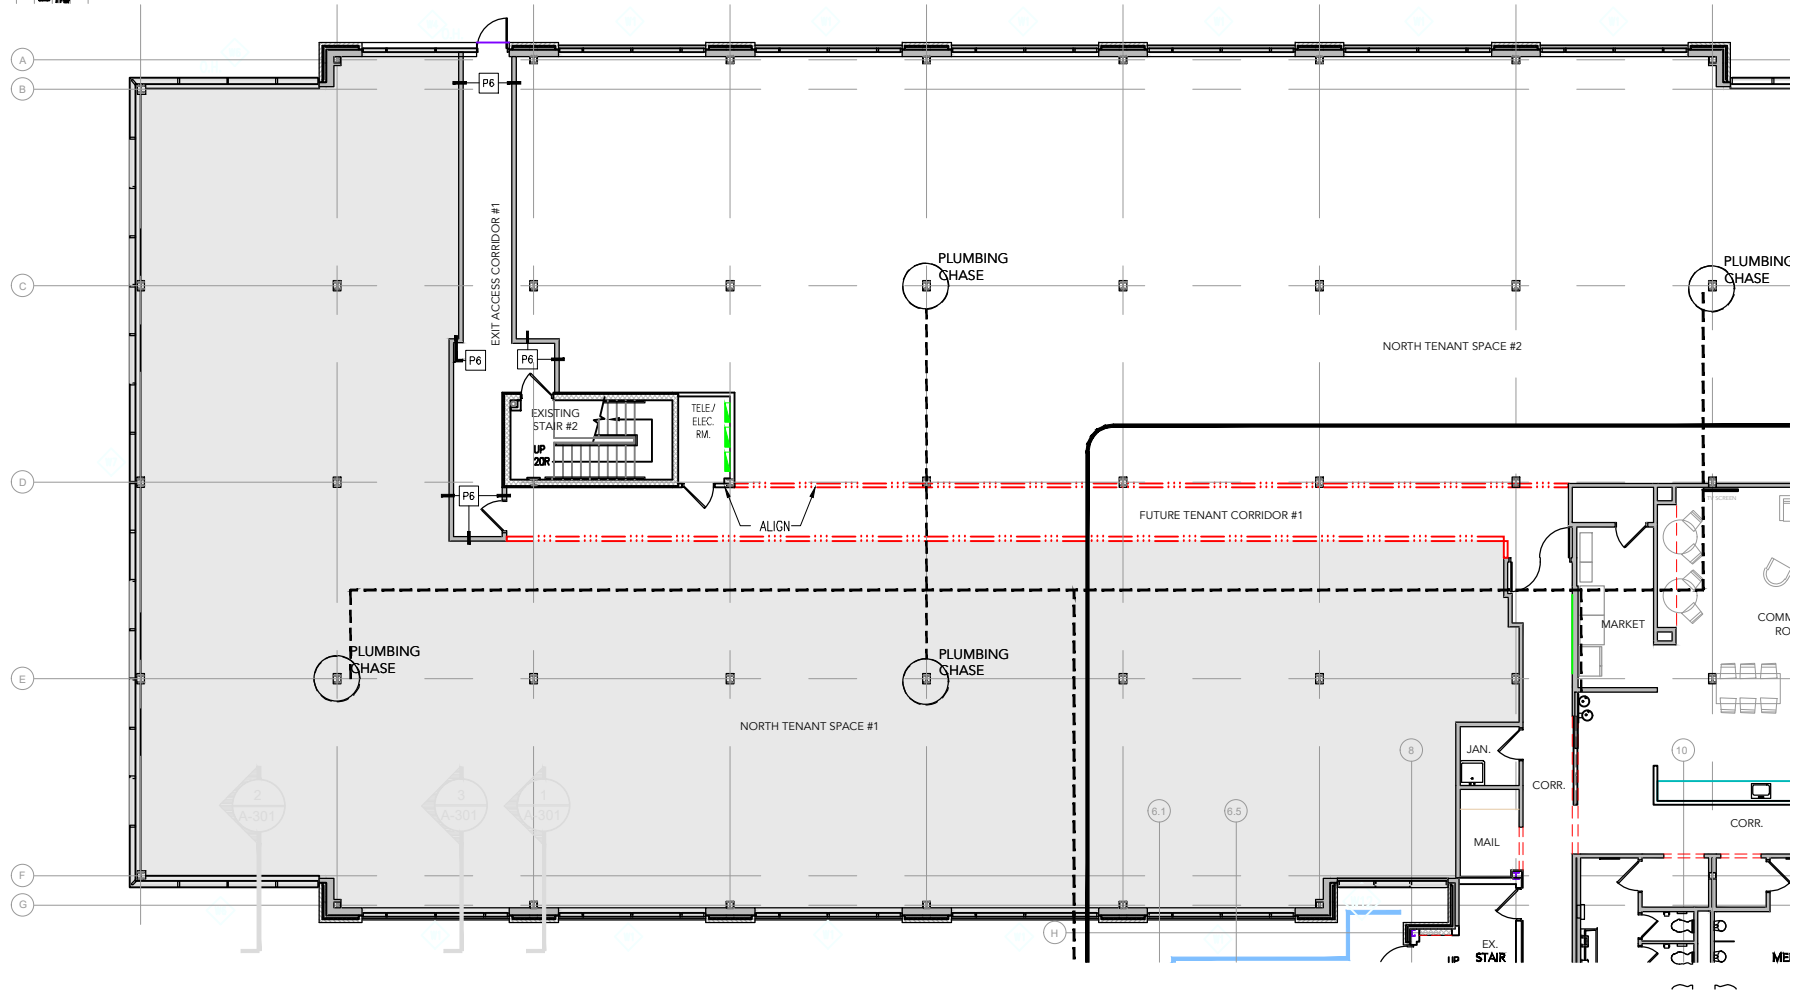


TOTAL SF AVAILABLE - 7,516 RSF(12%)

[Click to access CADD file](#)

Key Plan

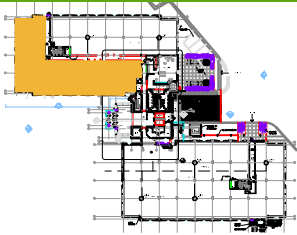

Floor Plan