
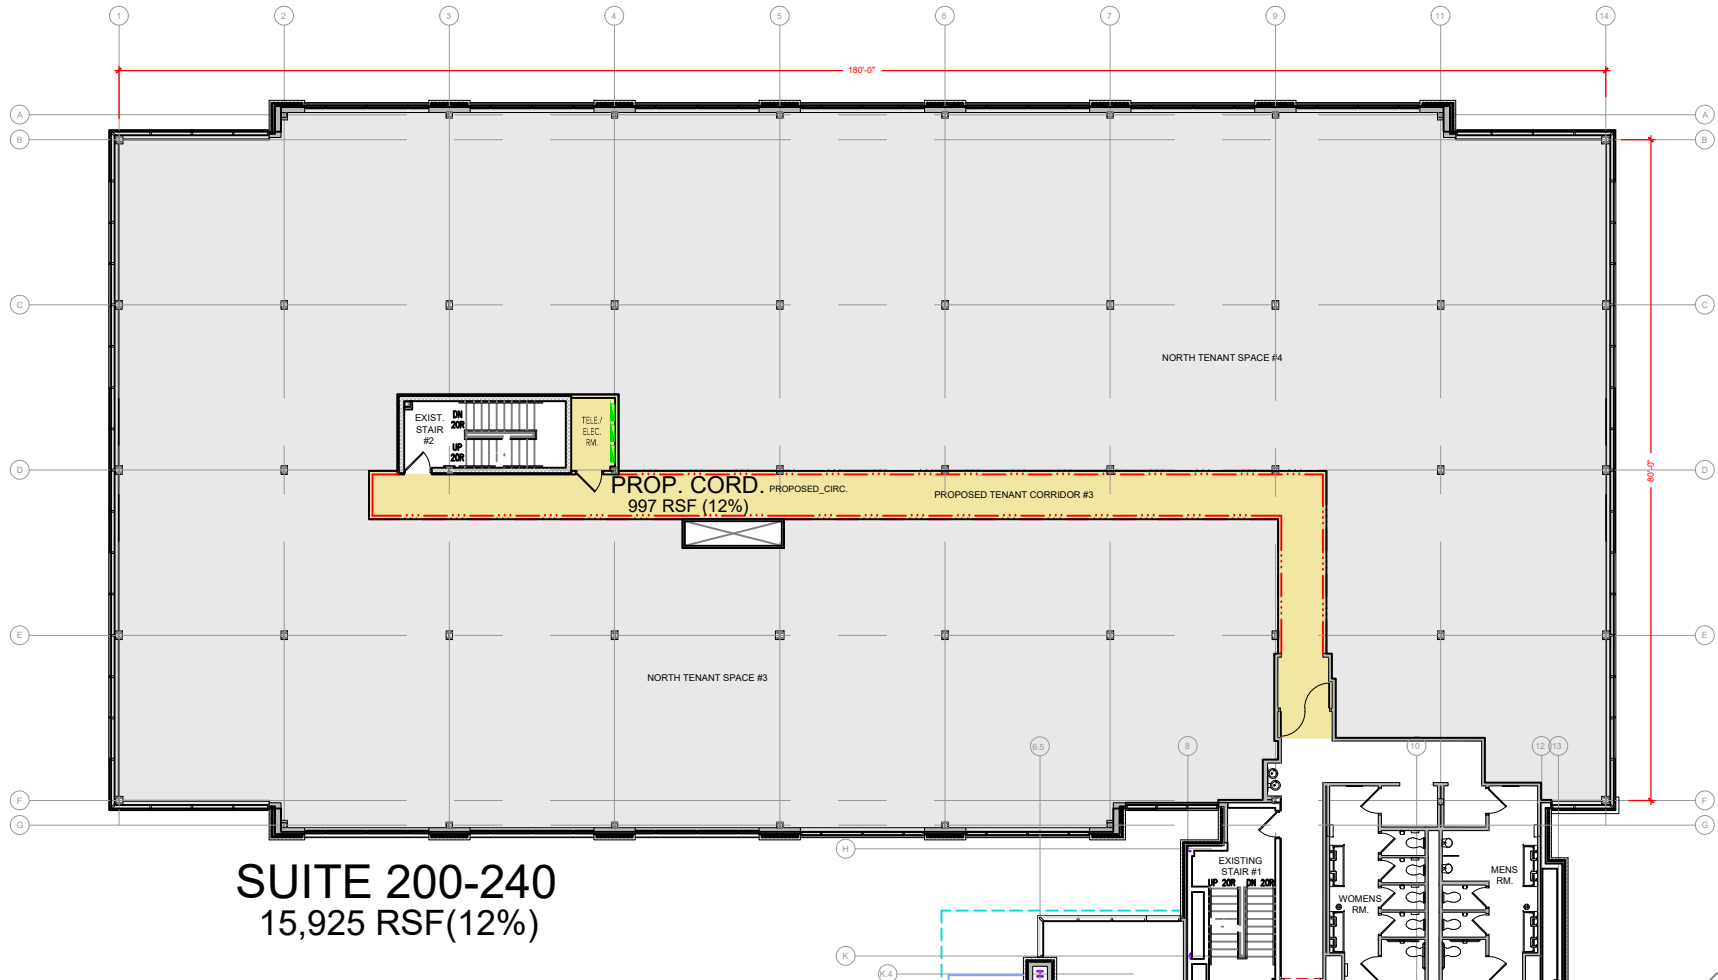


TOTAL SF AVAILABLE -15,295 RSF (12%)

[Click to access 3D model](#)

Key Plan

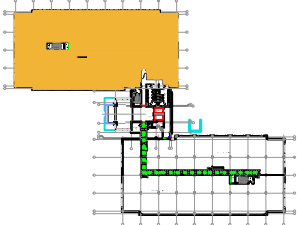

**SUITE 200-240**  
15,925 RSF(12%)

Floor Plan