



TOTAL SF AVAILABLE - 1,875 RSF(12%)

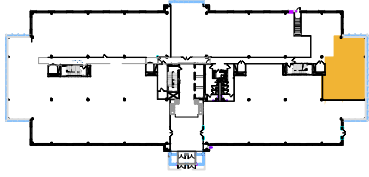

Key Plan

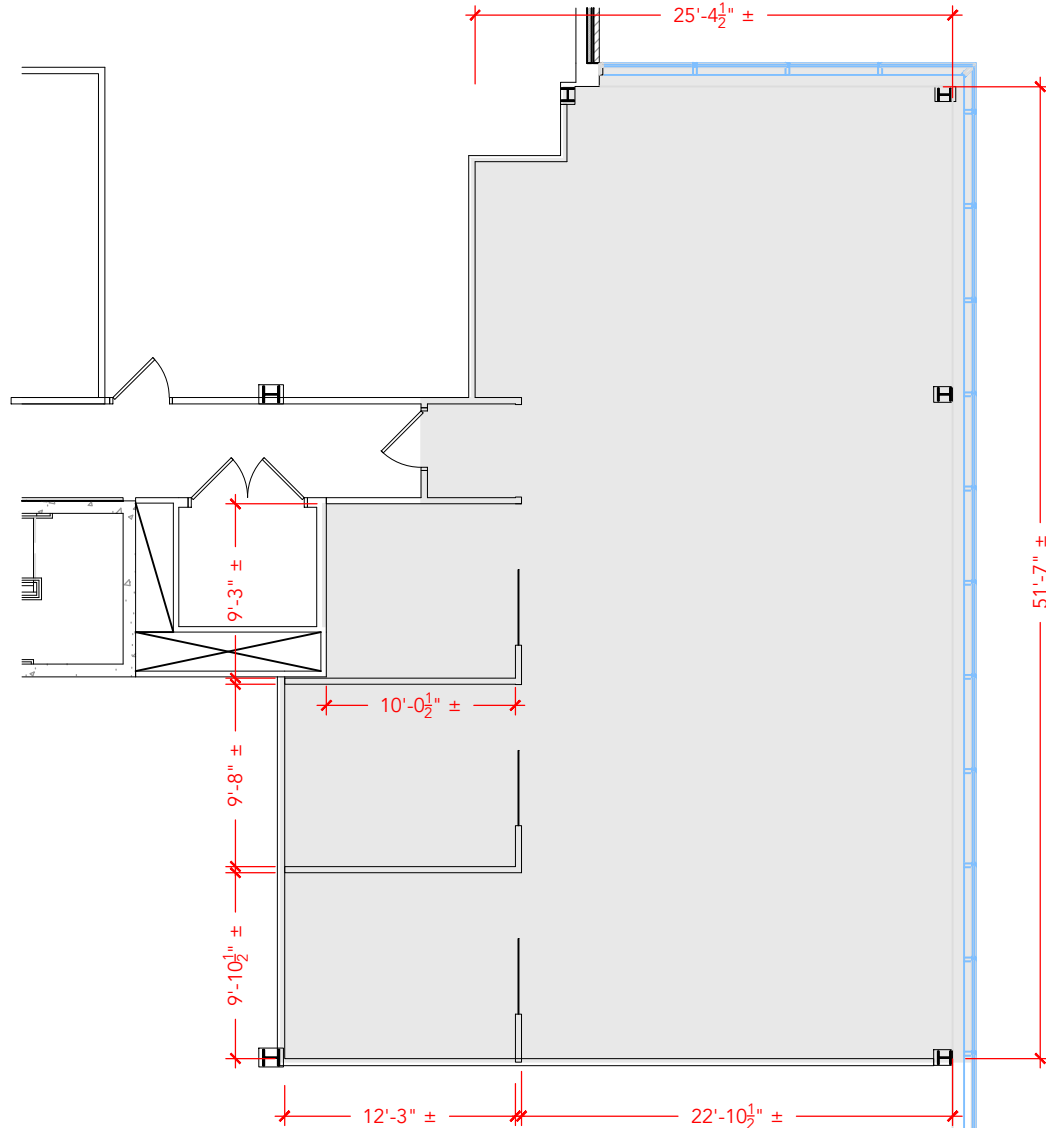

Floor Plan