



TOTAL SF AVAILABLE -1,894 RSF(12%)

[Click to access 3D model](#)

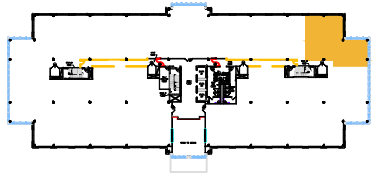

Key Plan

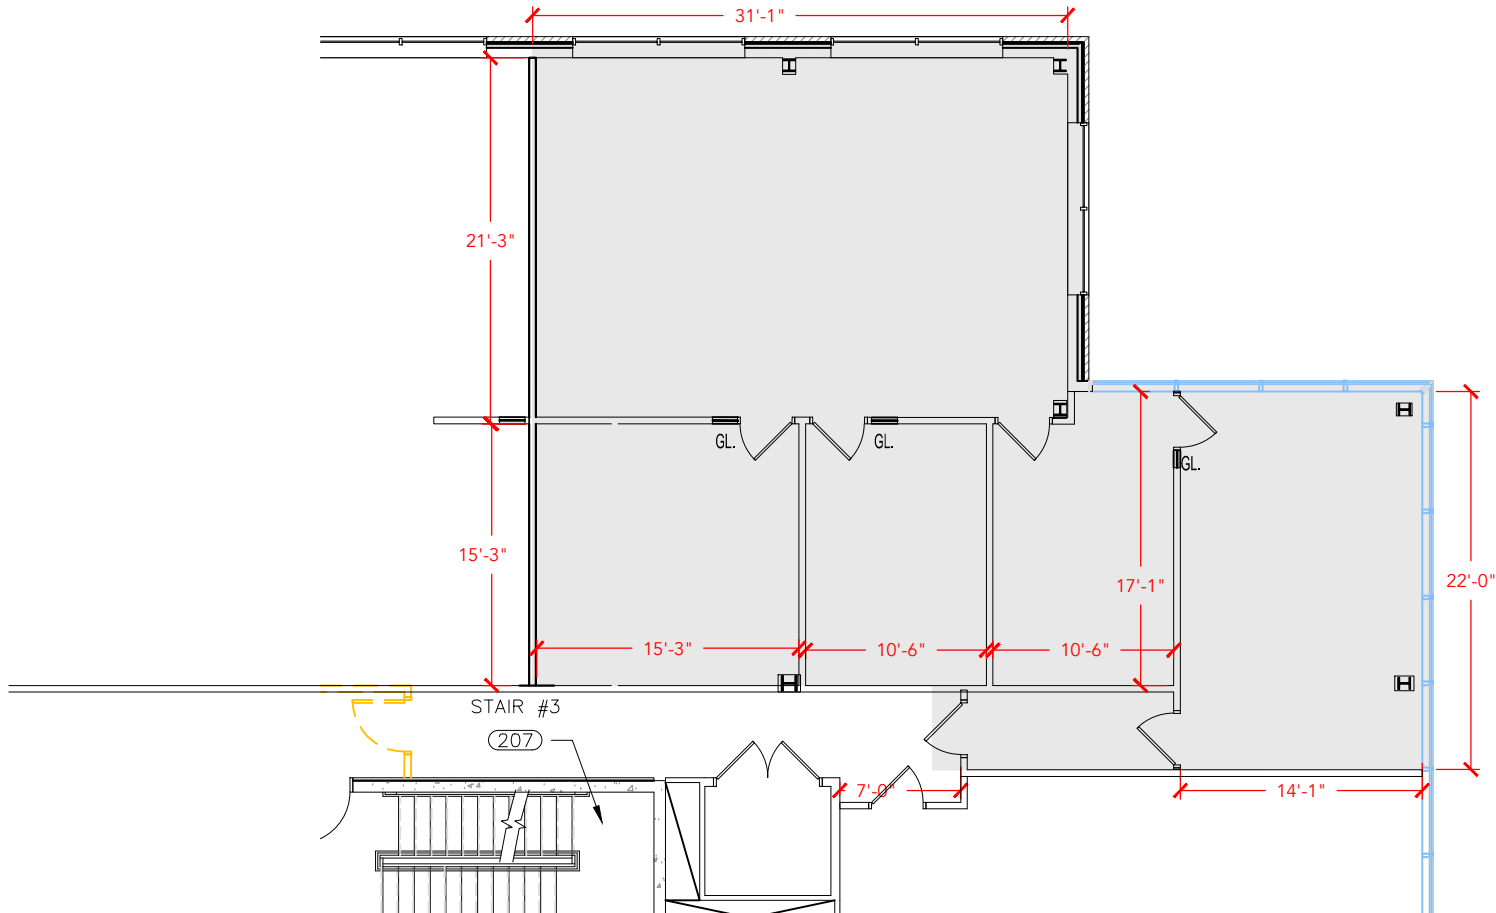

Floor Plan