




[Click to access3D model](#)

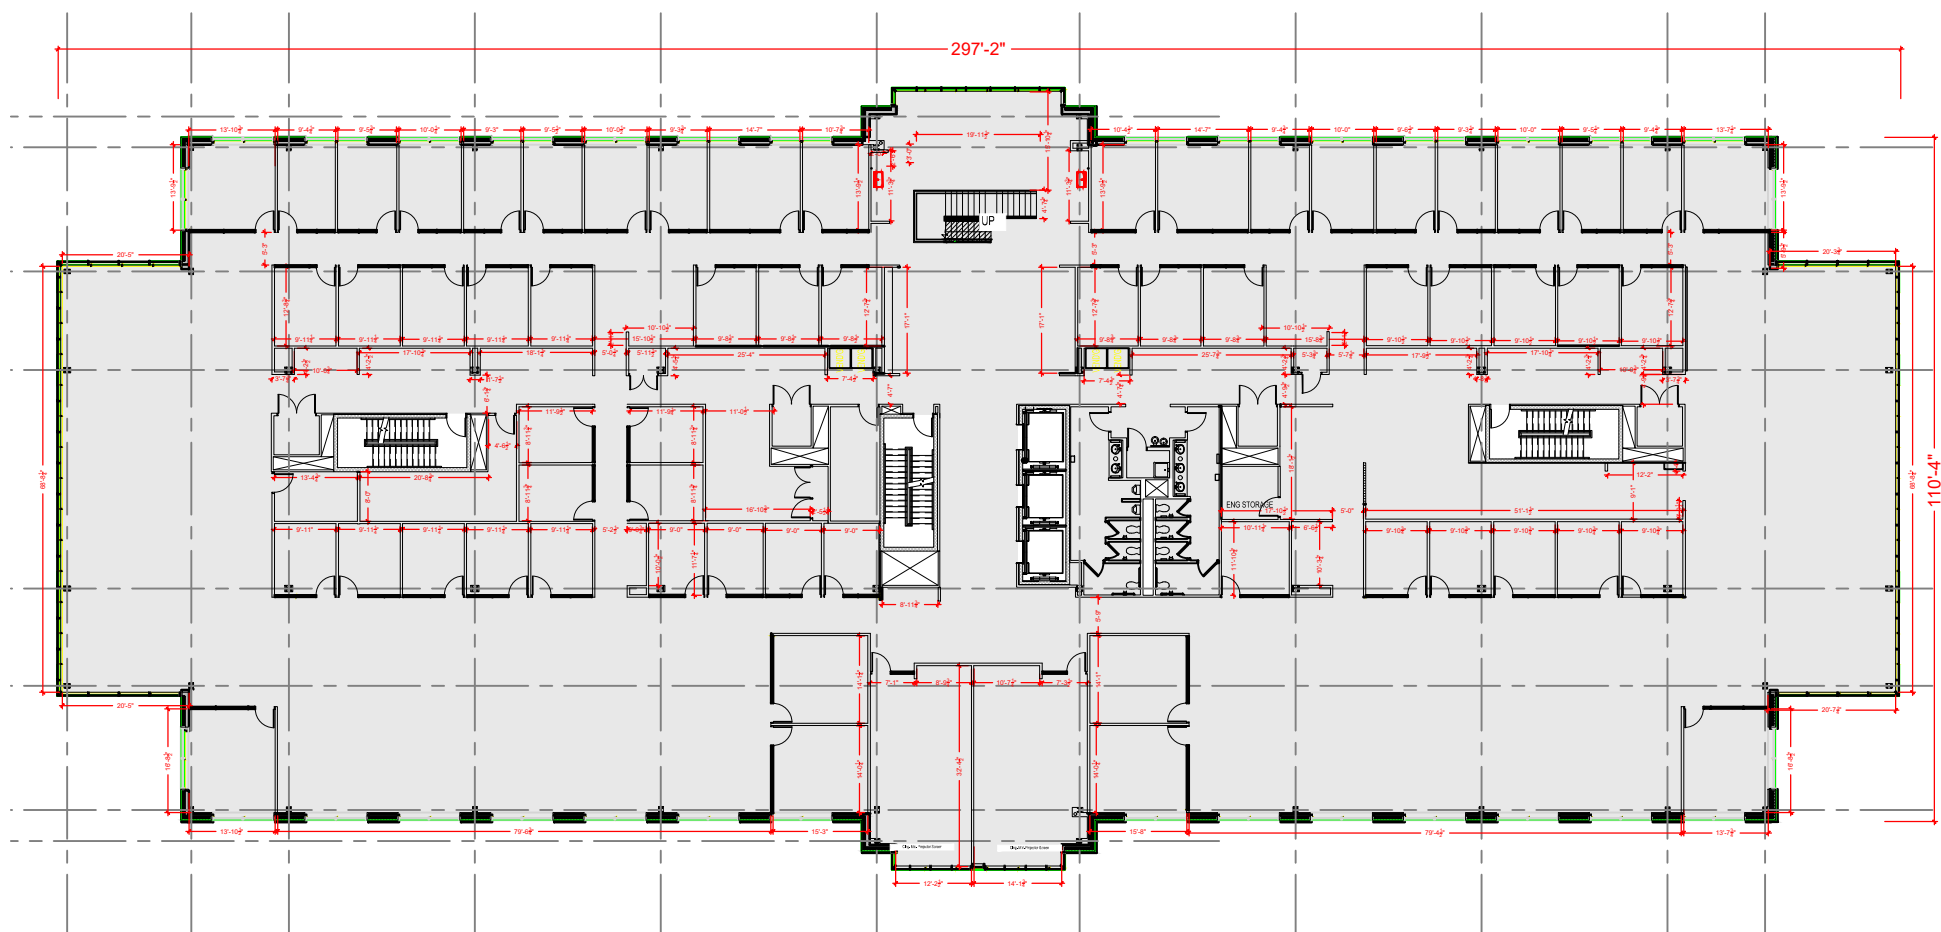

Floor Plan

DRAWING #: SC1B-300-395 ASBUILT DATE: **NEEDS TO BE**