


TOTAL SF AVAILABLE - 32,868 RSF (9%)

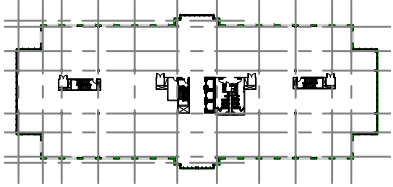

Key Plan

[Click to access 3D model](#)
[Click to view space Photos](#)



Floor Plan