


TOTAL SF AVAILABLE -4,799 SF

OFFICE - 4,799 SF
WAREHOUSE - 0,000 SF

[Click to access CADD file](#)

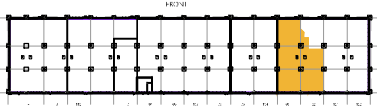

Key Plan

