



TOTAL SF AVAILABLE -13,629 SF  
OFFICE -13,629 SF  
WAREHOUSE -0 SF



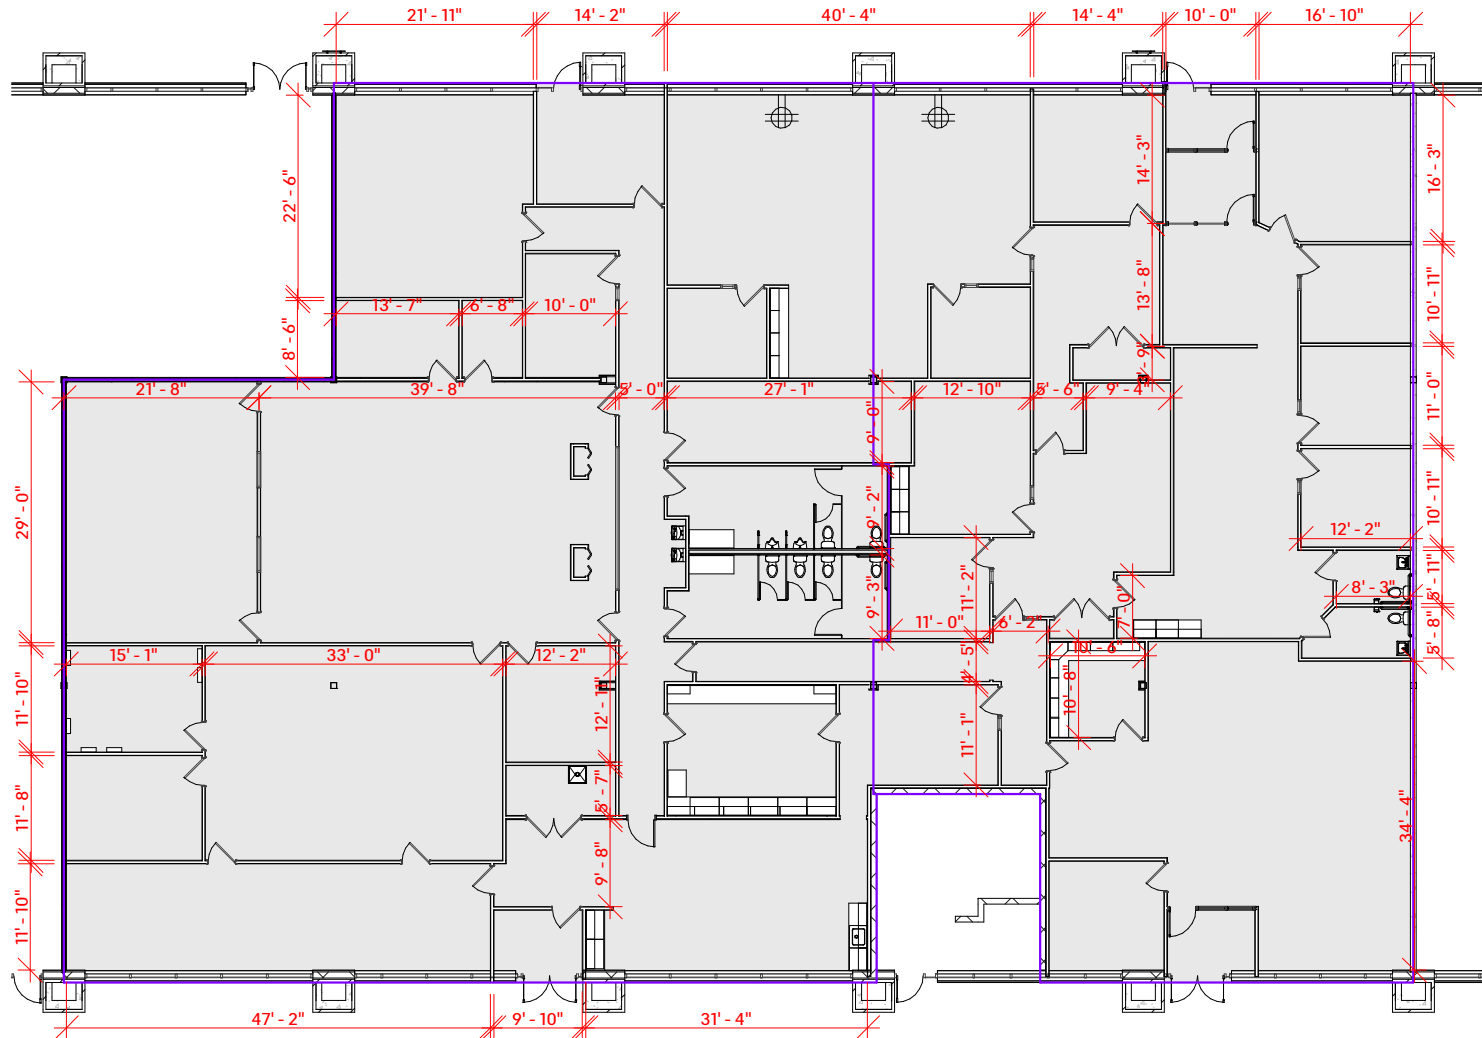

TOTAL SF AVAILABLE -13,629 SF  
OFFICE -13,629 SF  
WAREHOUSE -0 SF

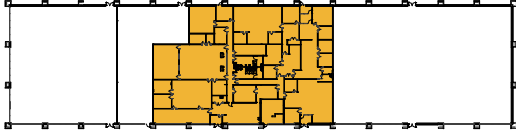