


TOTAL SF AVAILABLE - 30,250 SF


OFFICE - 7,166 SF

WAREHOUSE - 23,084 SF

[Click to access 3D model](#)

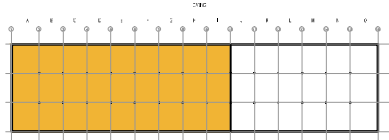

Key Plan

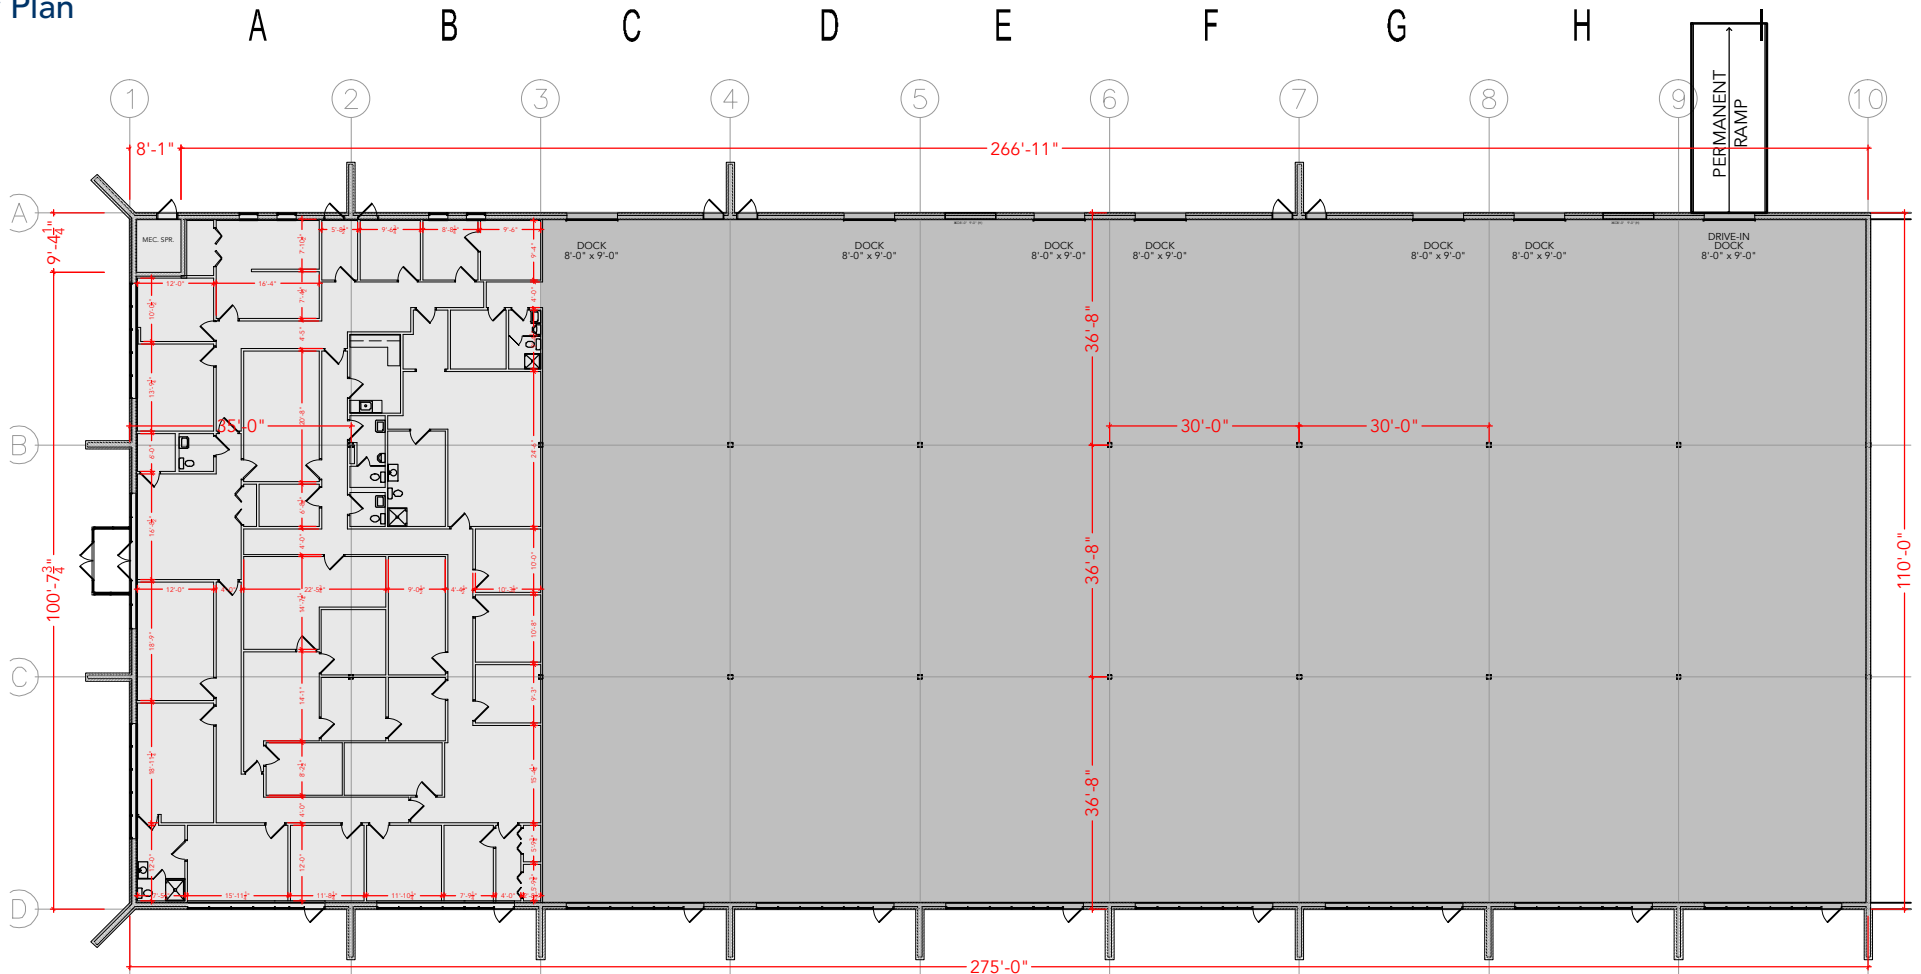

Floor Plan