


TOTAL SF AVAILABLE - 50,600 SF

OFFICE - 14,504 SF
WAREHOUSE - 36,096 SF

[Click to access 3D model](#)



Key Plan

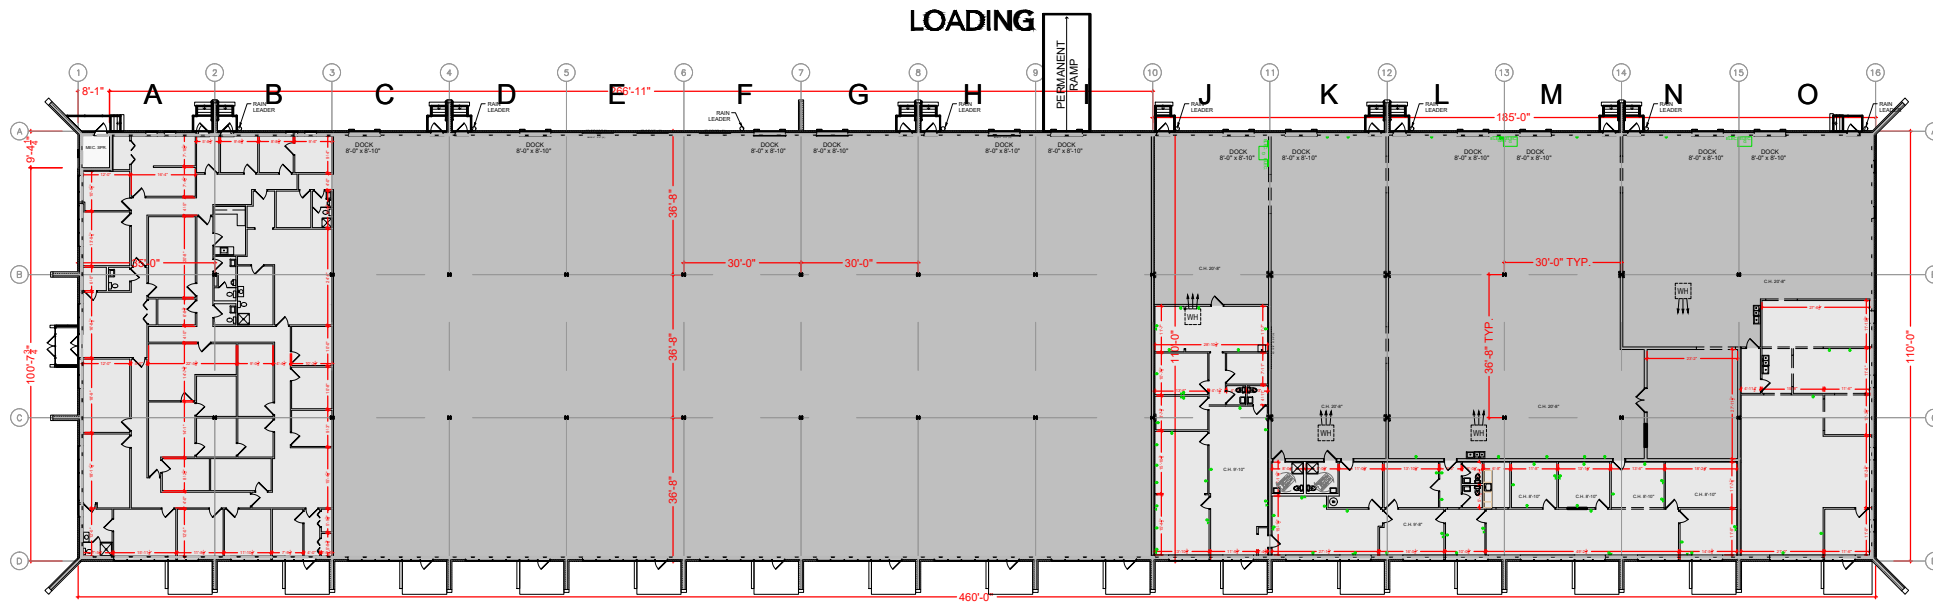

Floor Plan