


**TOTAL SF AVAILABLE - 4,200 SF**


**OFFICE - 2,787 SF**

**WAREHOUSE - 1,413 SF**

[Click to access 3D model](#)

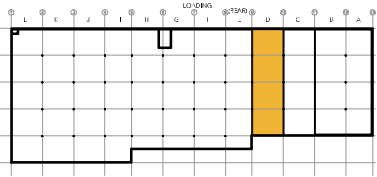

Key Plan

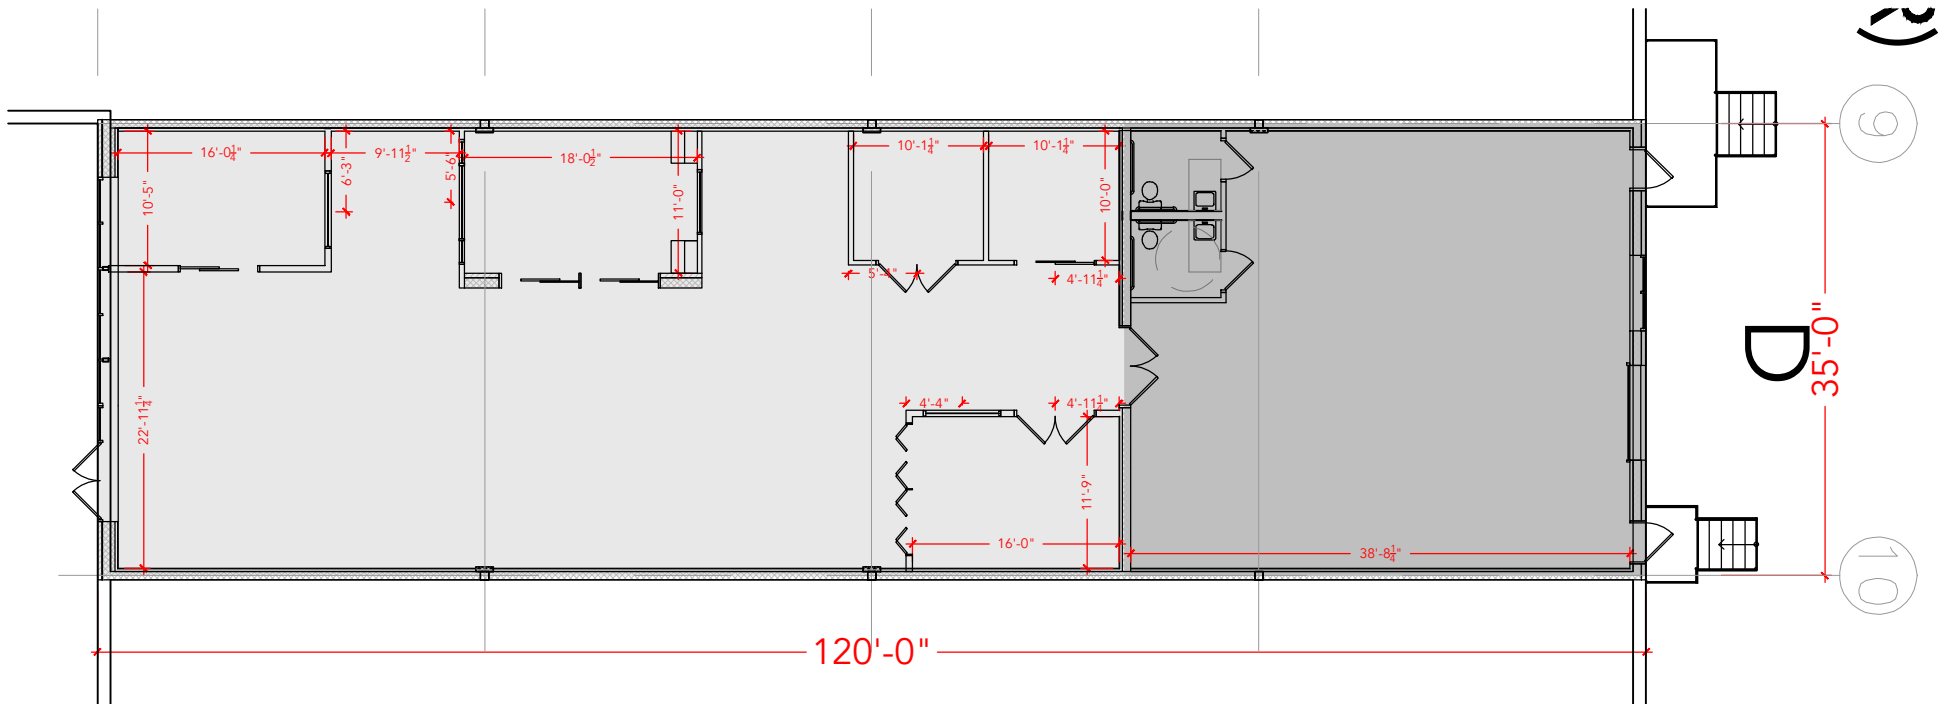

## Floor Plan