



TOTAL SF AVAILABLE -20,209 SF

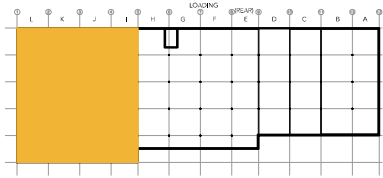

Key Plan

[Click to access 3D model](#)

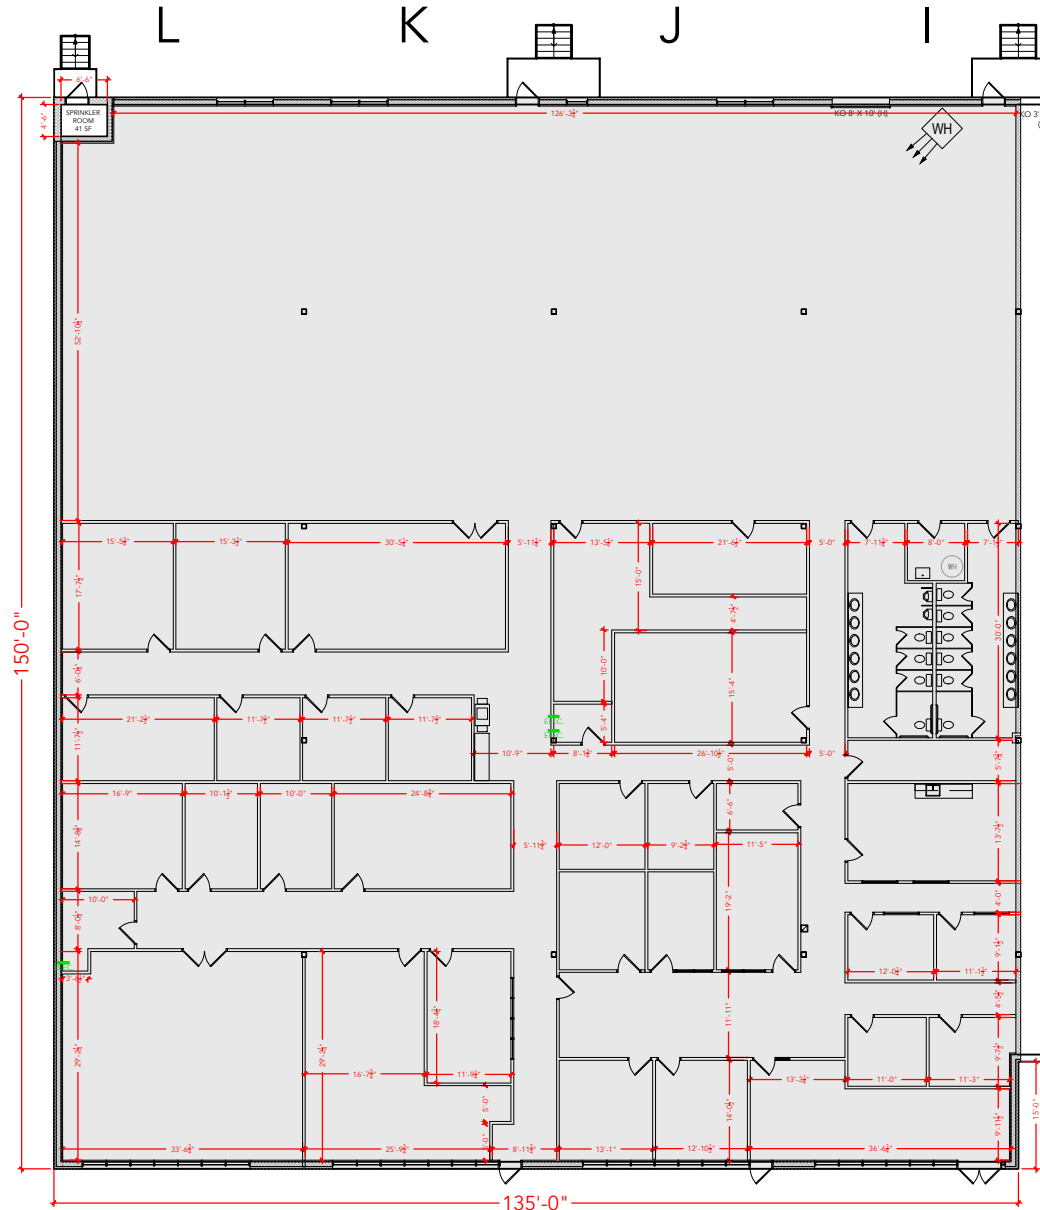

Floor Plan