


**TOTAL SF AVAILABLE - 20,209 SF**


OFFICE - 20,209 SF

WAREHOUSE - 0,000 SF

[Click to access 3D model](#)

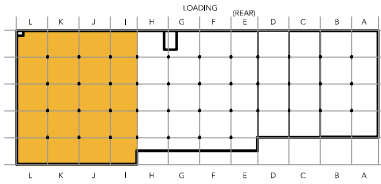

Key Plan

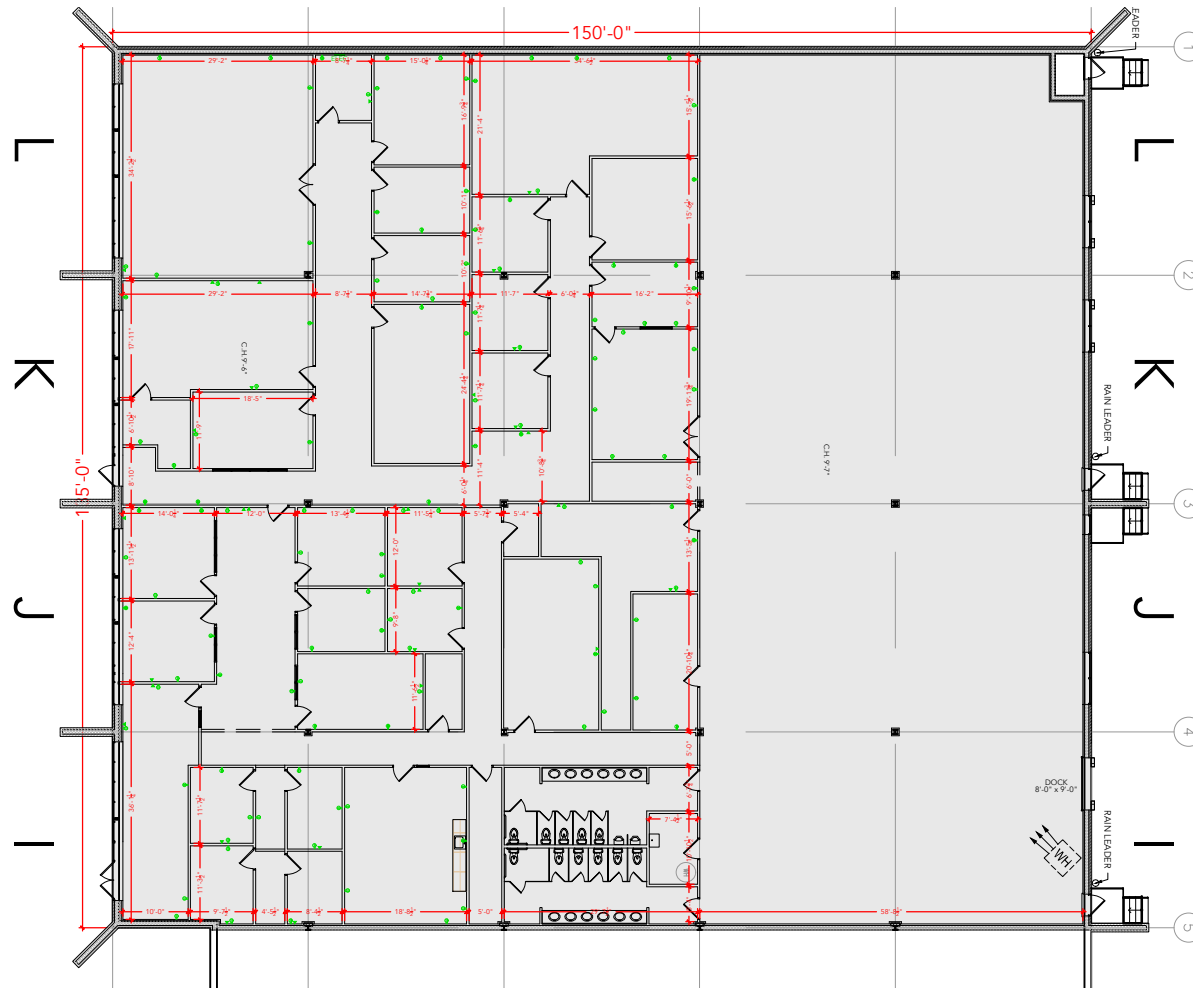

Floor Plan