

TOTAL SF AVAILABLE - 25,200 SF

OFFICE - 25,200 SF


WAREHOUSE - 0,000 SF

[Click to access 3D model](#)

LOADING

A	B	C	D	E	F	G	H	I	J	K	L	M	N	O	P	Q	R

Key Plan

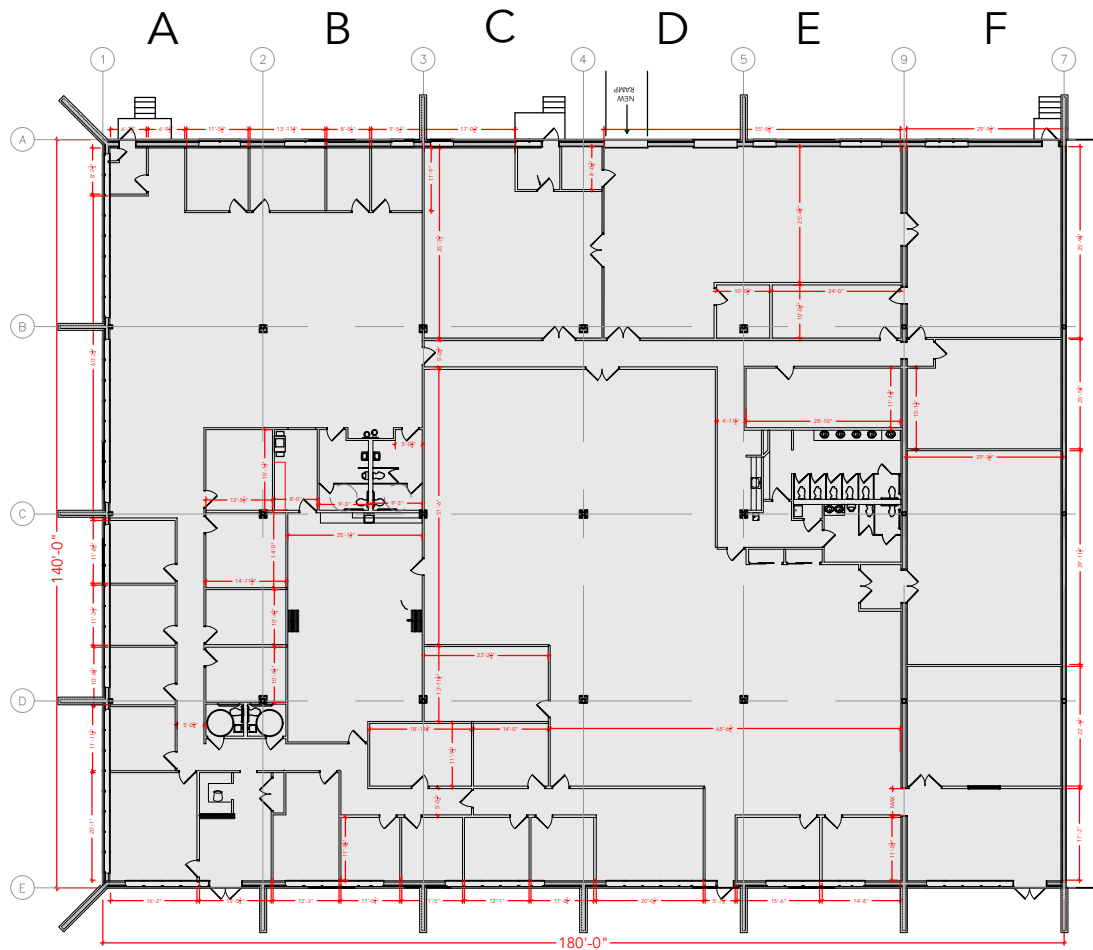

Floor Plan