


TOTAL SF AVAILABLE -25,200 SF

OFFICE - 21,760 SF

WAREHOUSE - 3,440 SF

[Click to access CADD file](#)

Key Plan

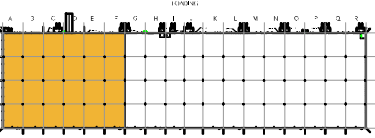

Floor Plan

