


TOTAL SF AVAILABLE – 4,200 SF


OFFICE – 1,333 SF

WAREHOUSE – 2,867 SF

[Click to access CADD file](#)

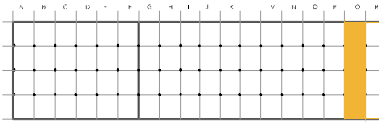

## Key Plan

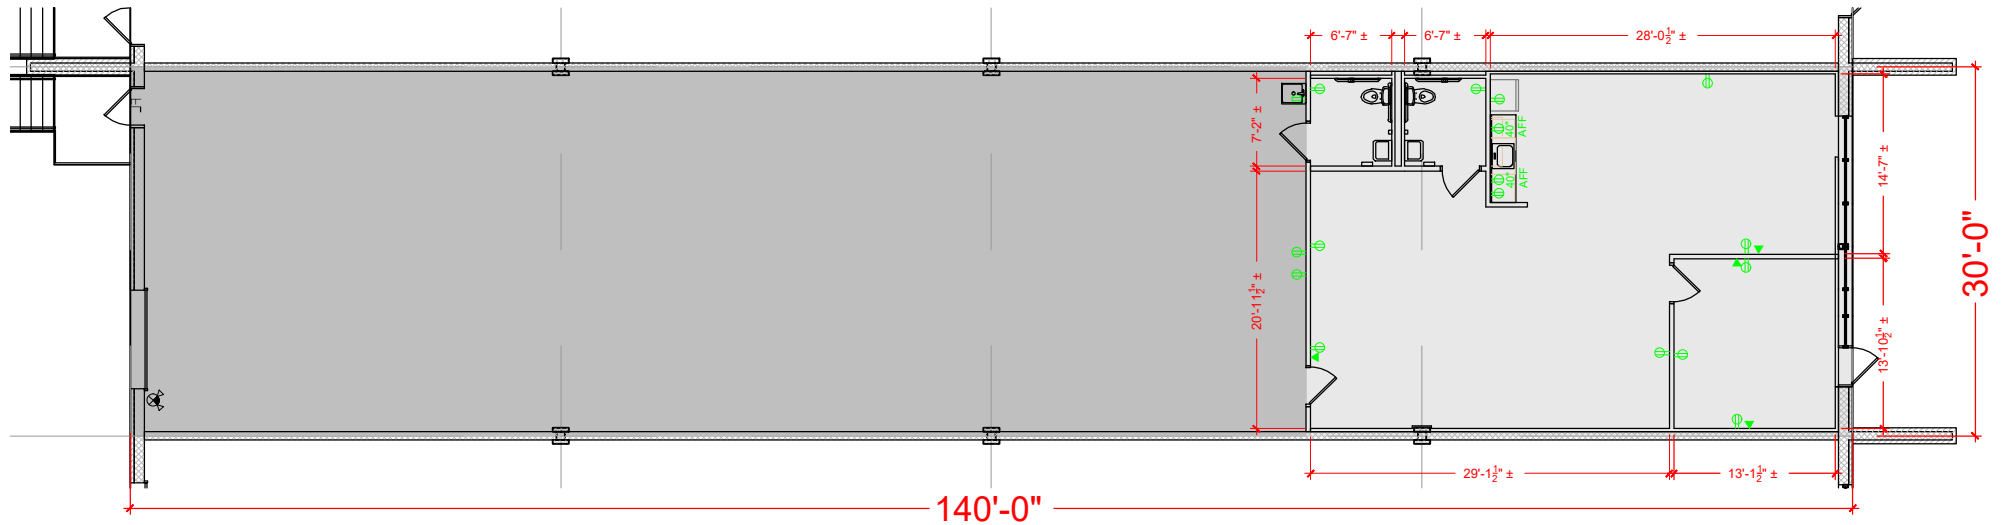

## Floor Plan