


TOTAL SF AVAILABLE -4,200 SF


OFFICE - 1,333 SF

WAREHOUSE - 2,867 SF

[Click to access CADD file](#)

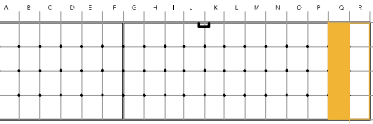

Key Plan

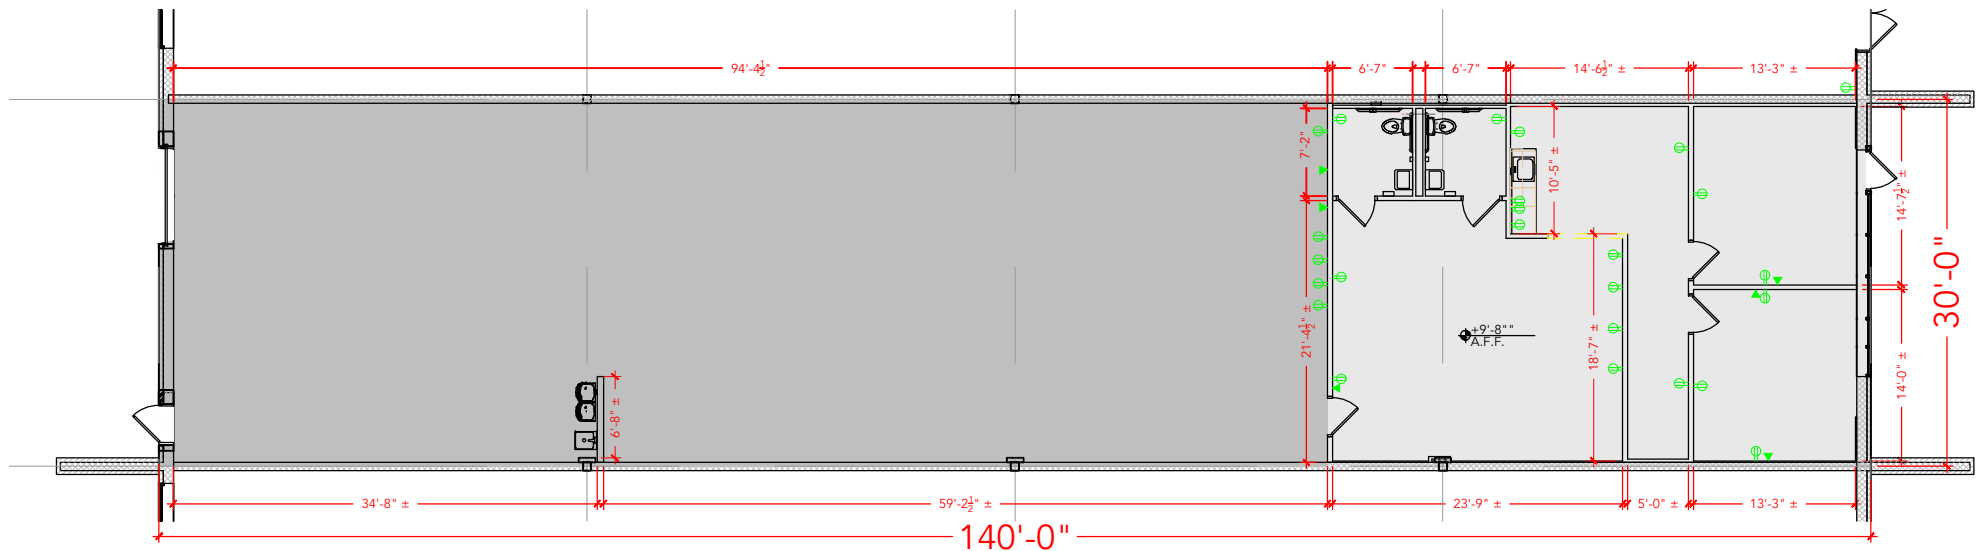

Floor Plan