


TOTAL SF AVAILABLE -11,655 RSF (12%)



Key Plan

[Click to access CADD file](#)

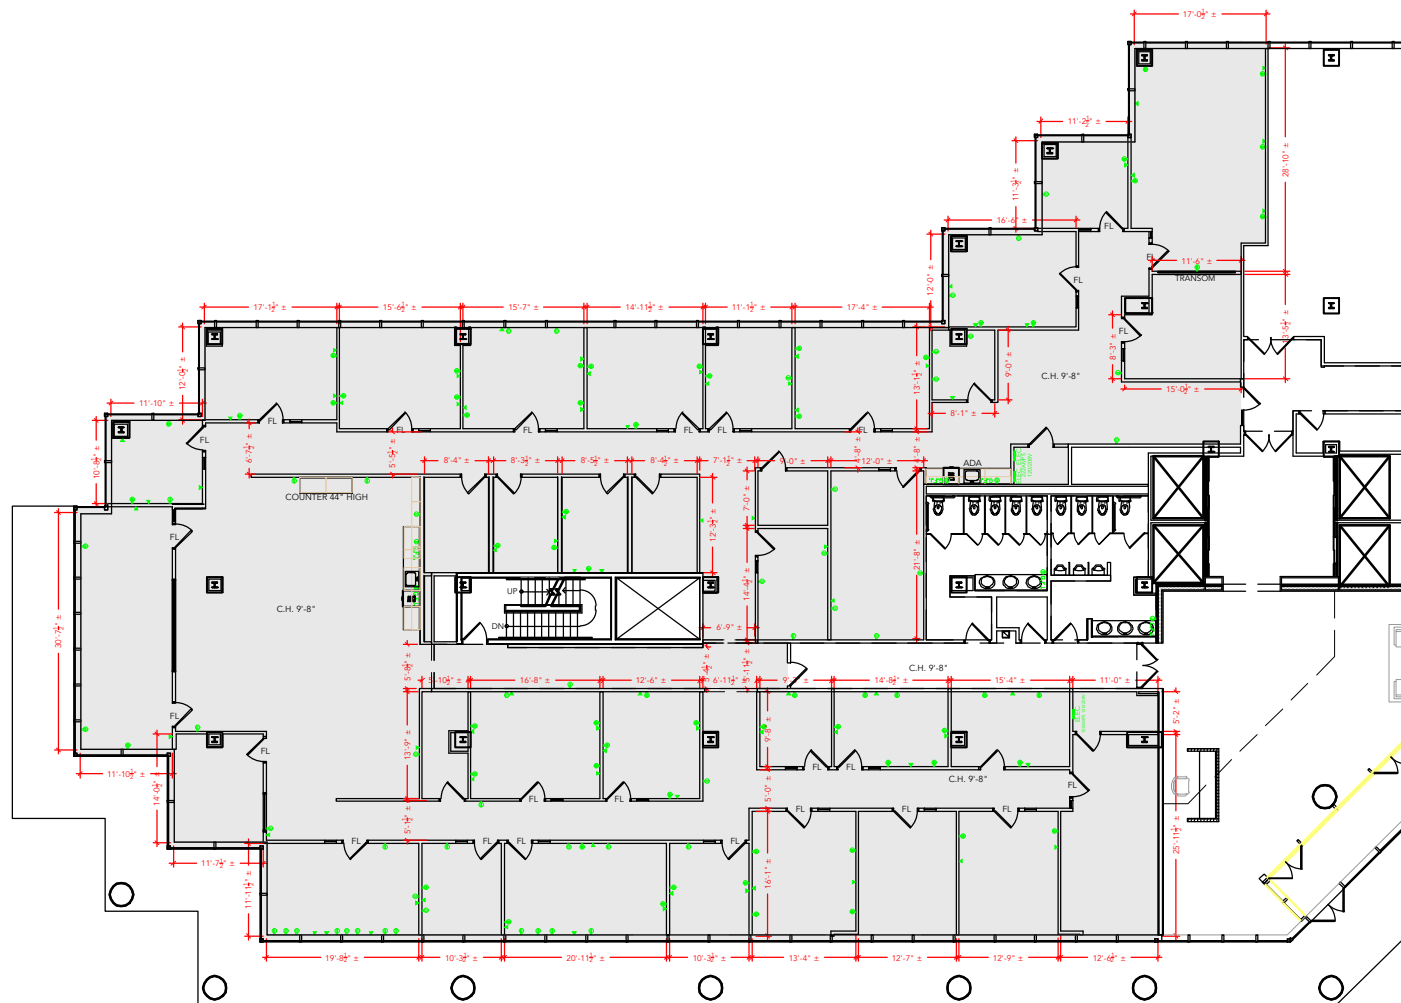

Floor Plan