
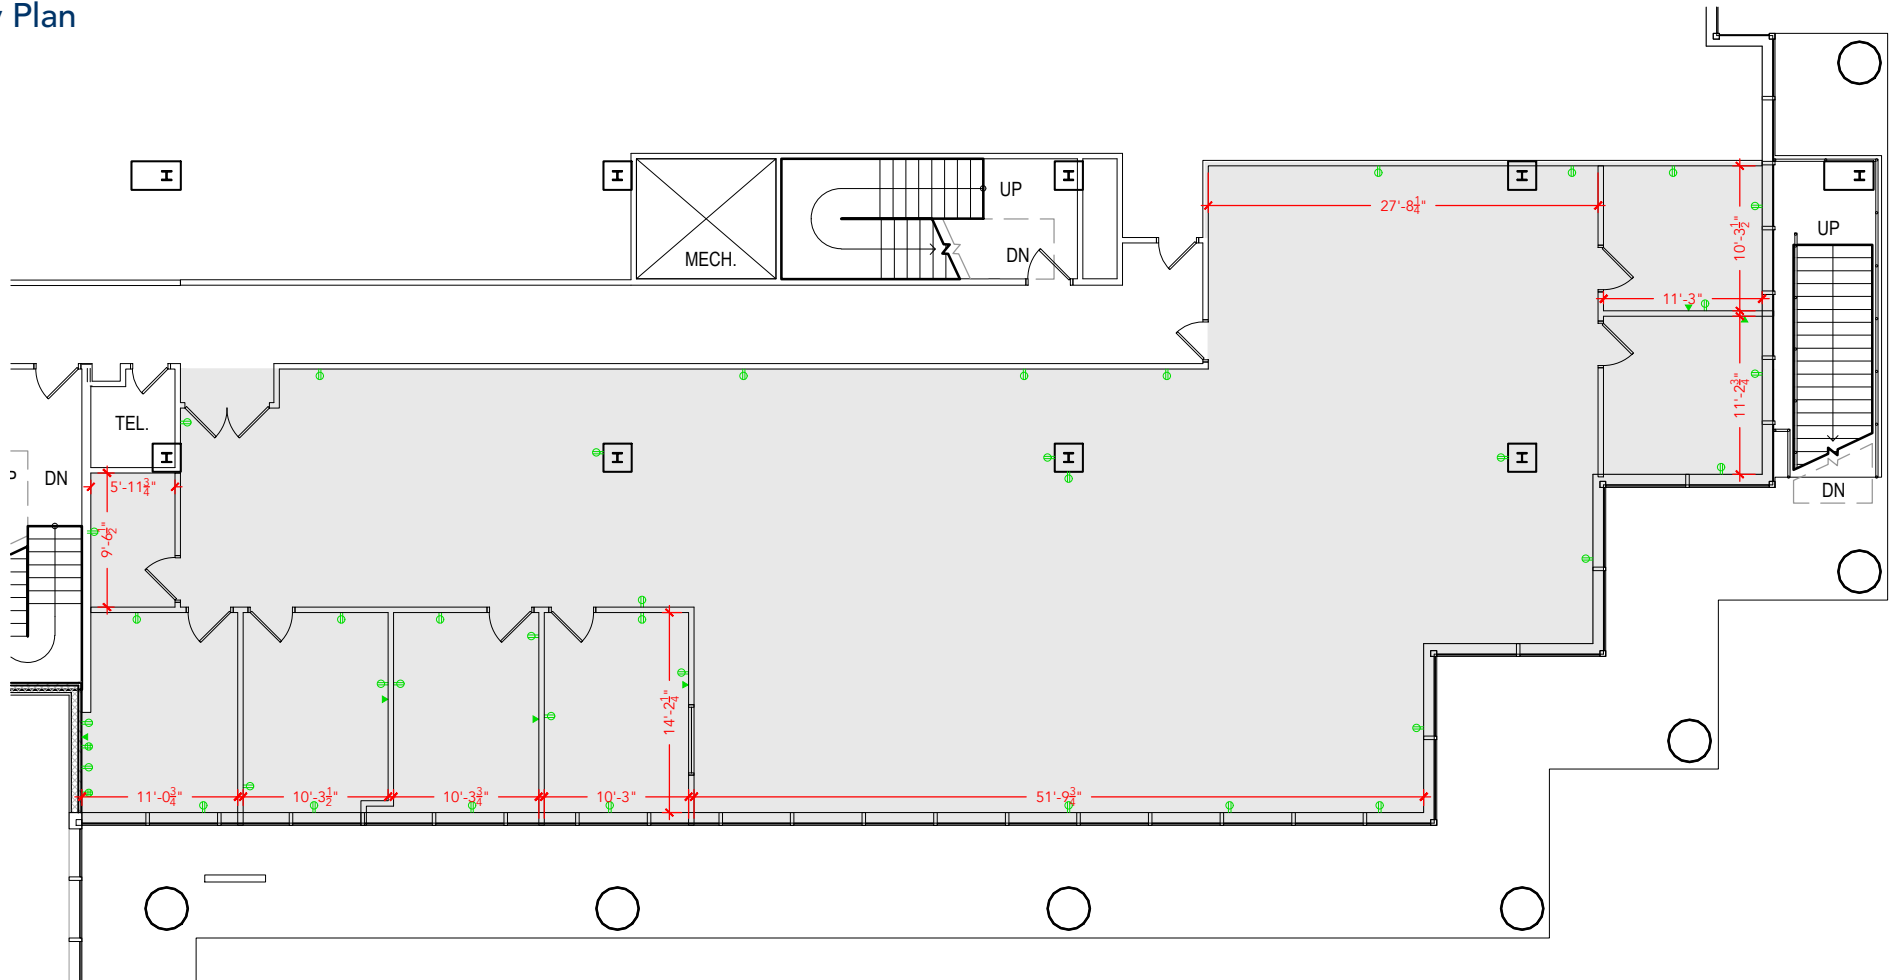


TOTAL SF AVAILABLE - 4,436 RSF(12%)

[Click to access 3D model](#)

Key Plan

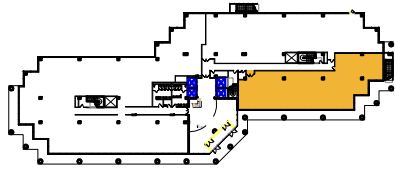

Floor Plan