


## TIMONIUM ONE

1966 GREENSPRING DRIVE TIMONIUM, MD 21093 SUITE 200-290

## TOTAL SF AVAILABLE - 27,351 RSF(9%)

Click to access3D model

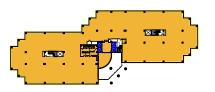

Key Plan

