



TOTAL SF AVAILABLE - 952 RSF(12%)

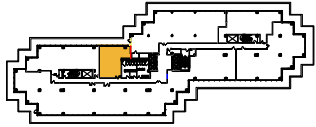

[Click to access CADD file](#)

Key Plan

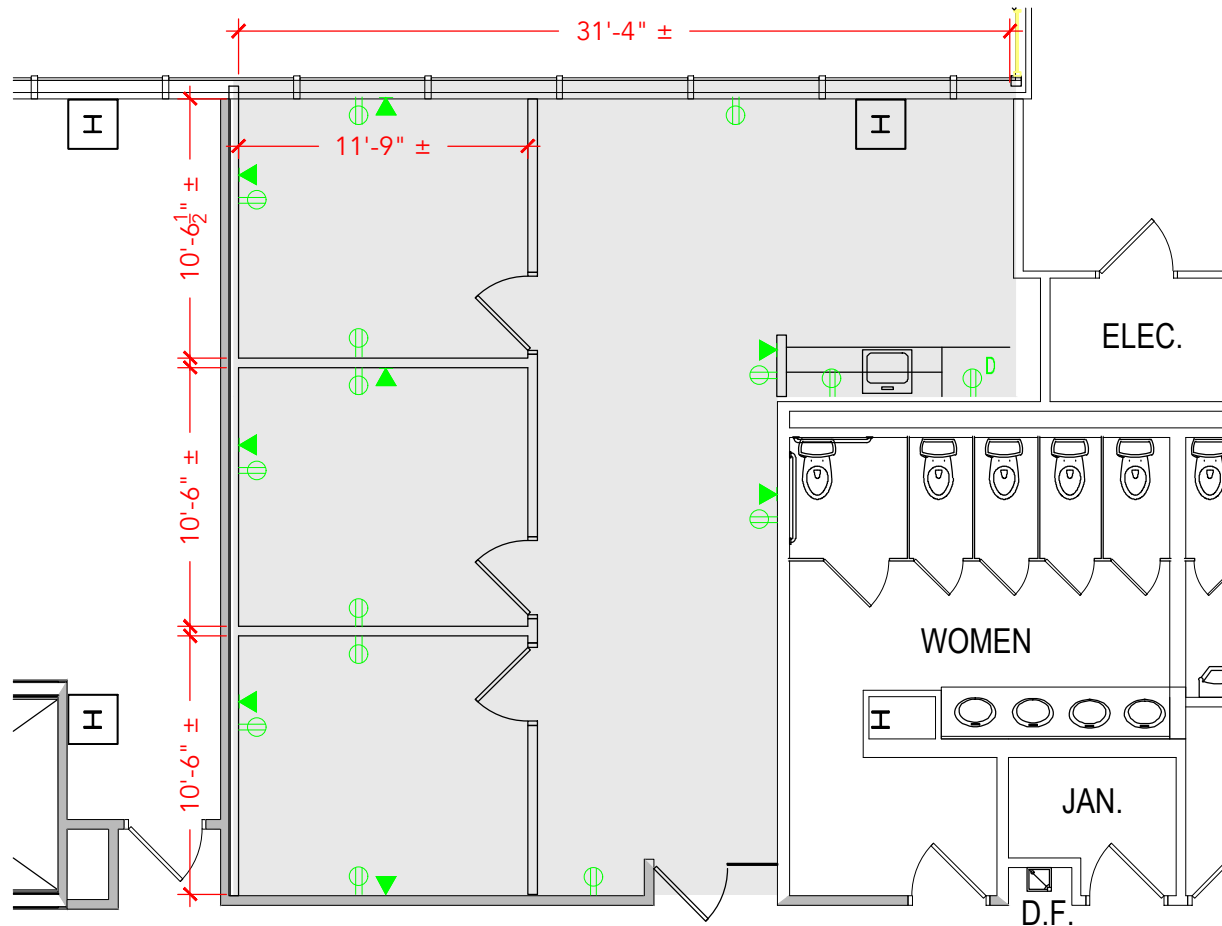

Floor Plan