



TOTAL SF AVAILABLE - 21,808 RSF(9%)

[Click to access 3D model](#)

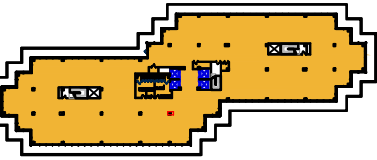

Key Plan

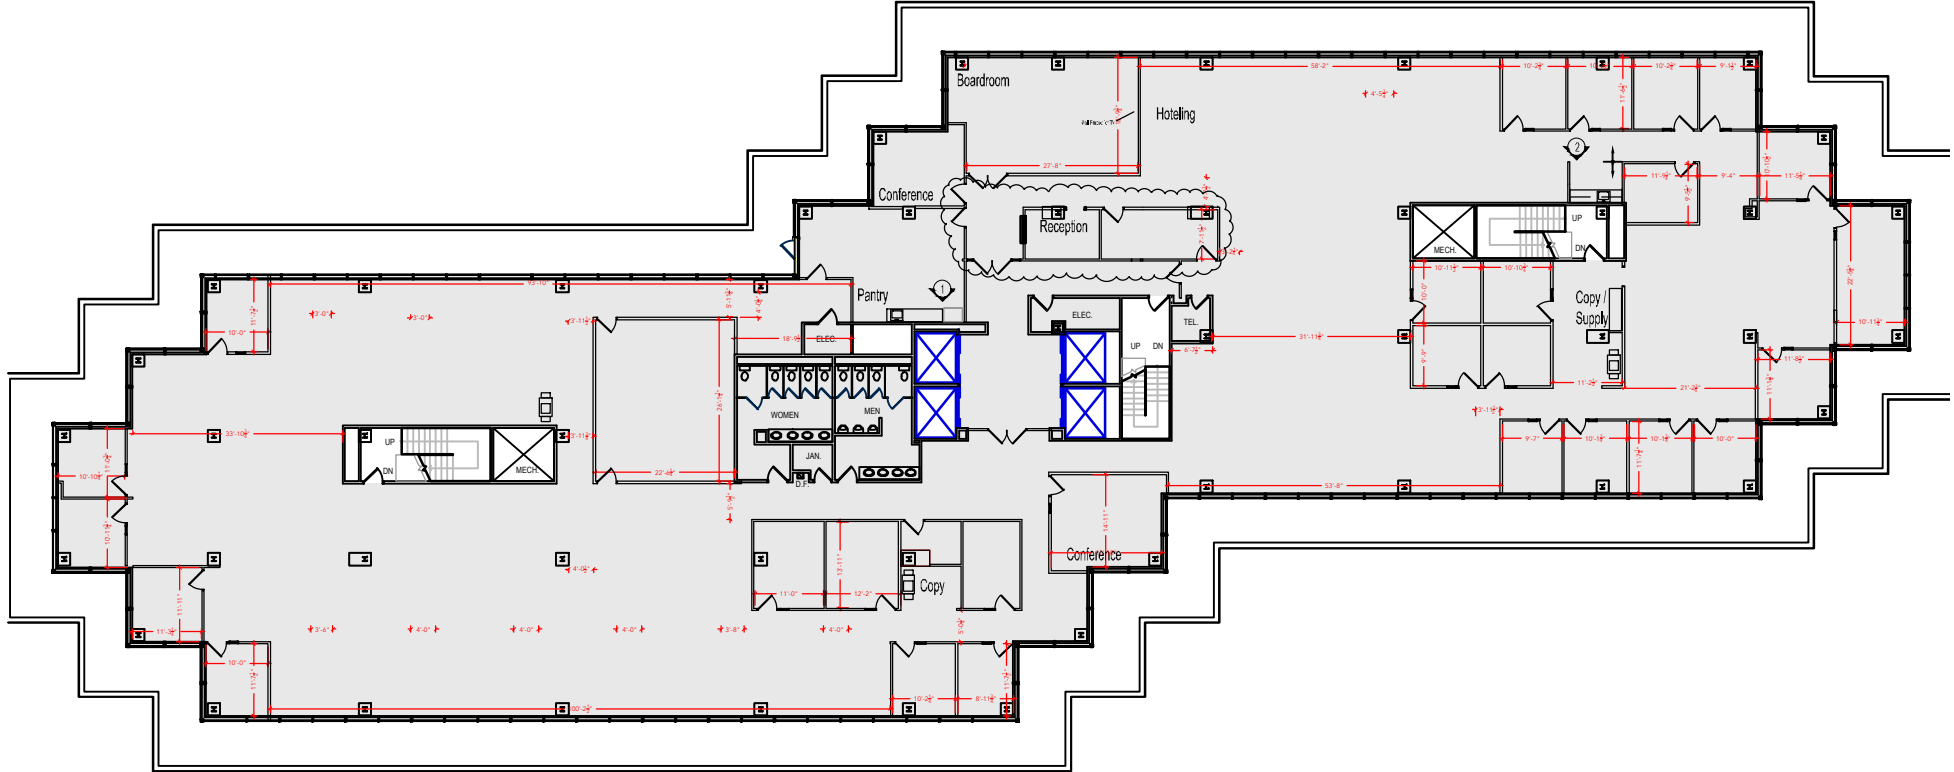

Floor Plan