


TOTAL SF AVAILABLE - 21,808 RSF(9%)



[Click to access 3D model](#)

Key Plan

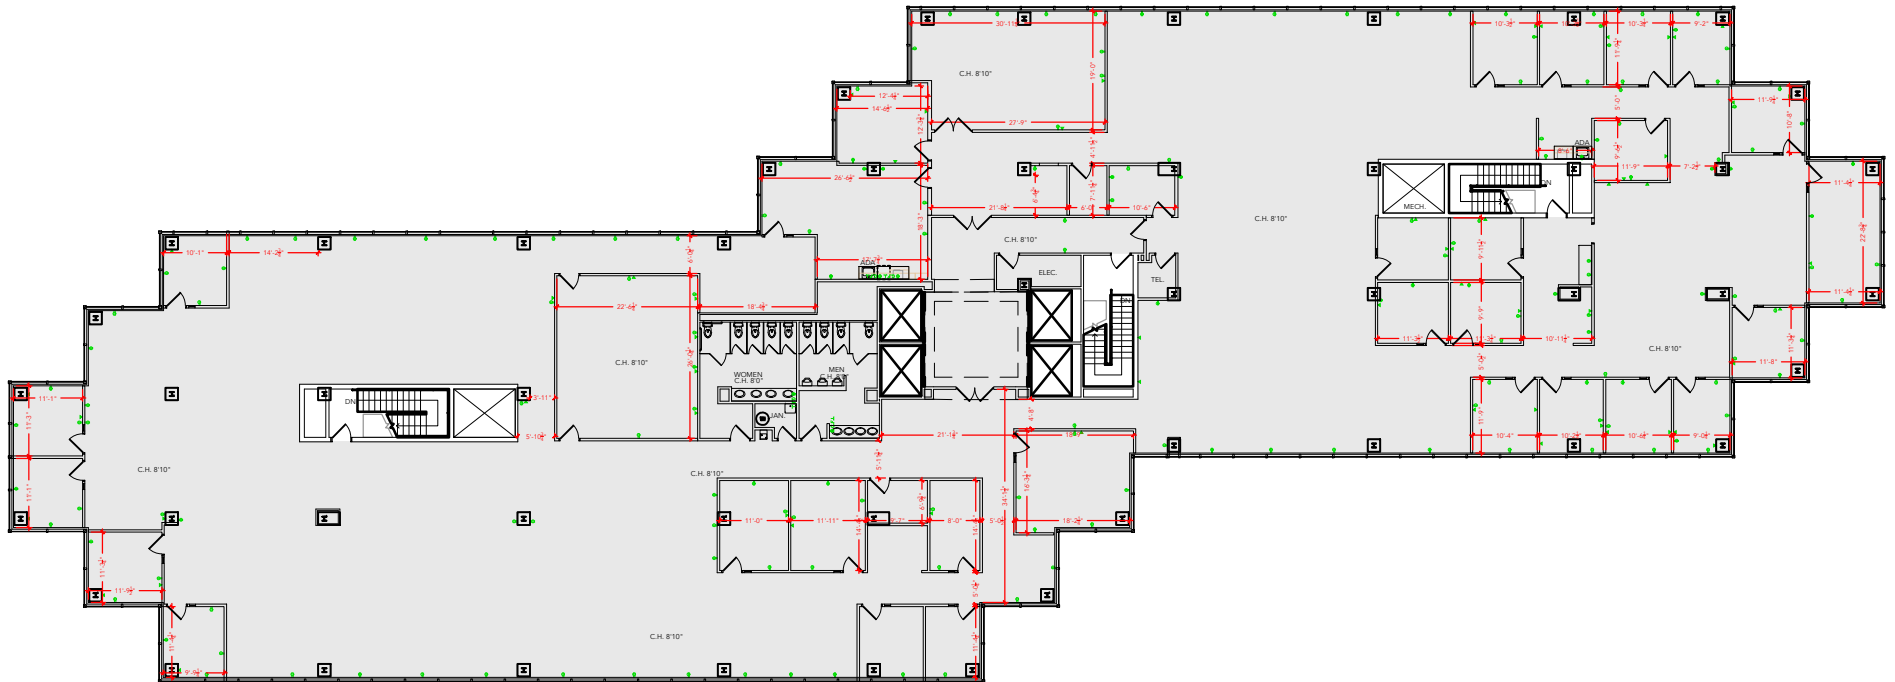

Floor Plan