



TOTAL SF AVAILABLE - 2,344 RSF (12%)

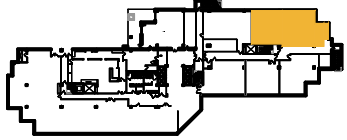

[Click to access CADD file](#)

Key Plan

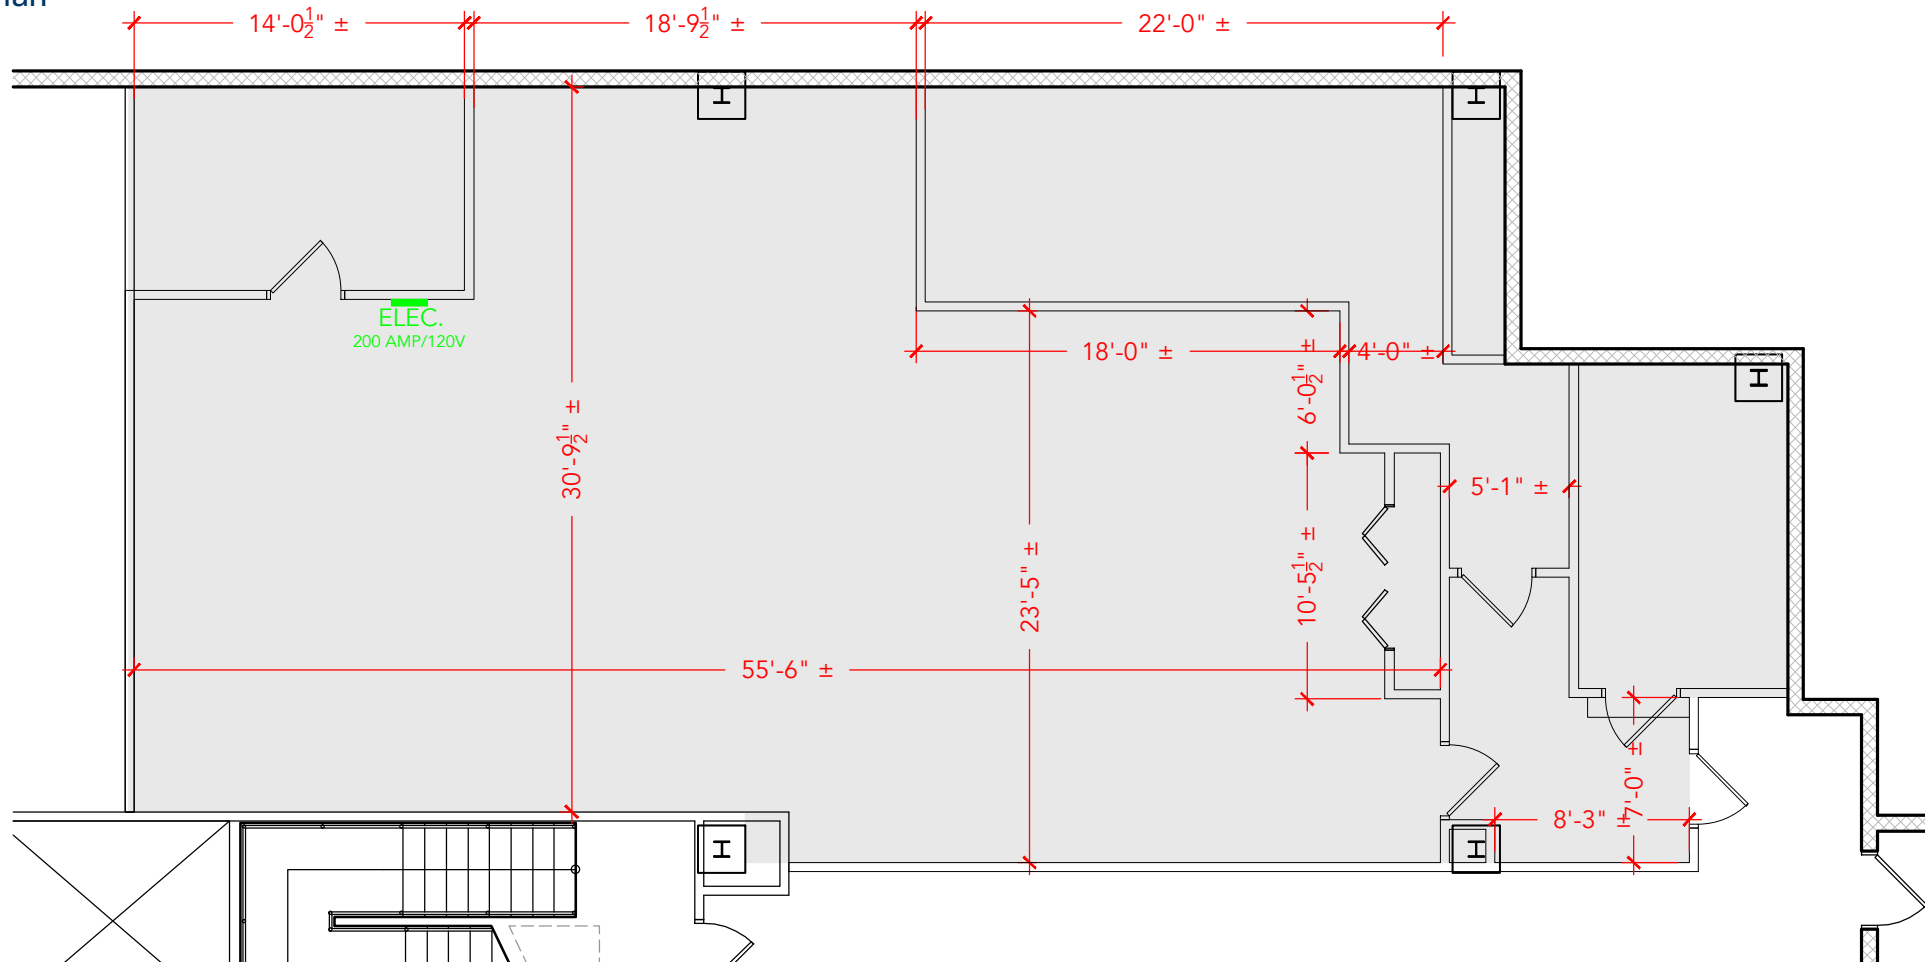

Floor Plan